


T.31S.,R.15W.,W.M.

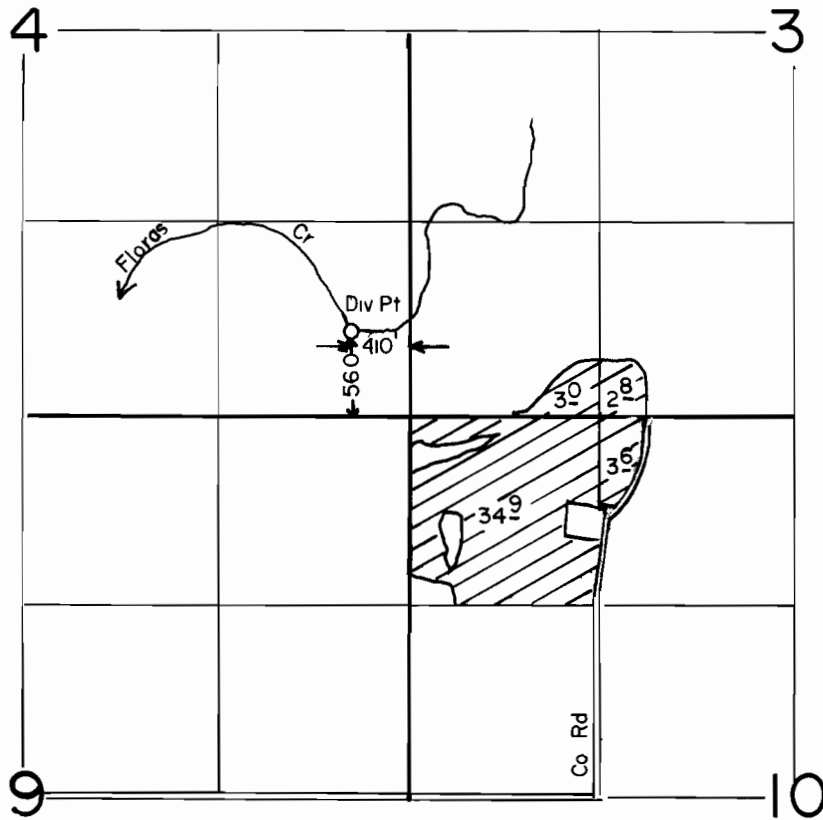

SCALE:1"=1320'


**FINAL PROOF SURVEY**  
UNDER

Application No. 57285... Permit No. 44510.....  
IN NAME OF

...**RODERICK & SHELLEY MCKENZIE**...

Surveyed JUNE 28, 1988., by B.S. JAMES.....

T. 31S., R. 15W., W. M.

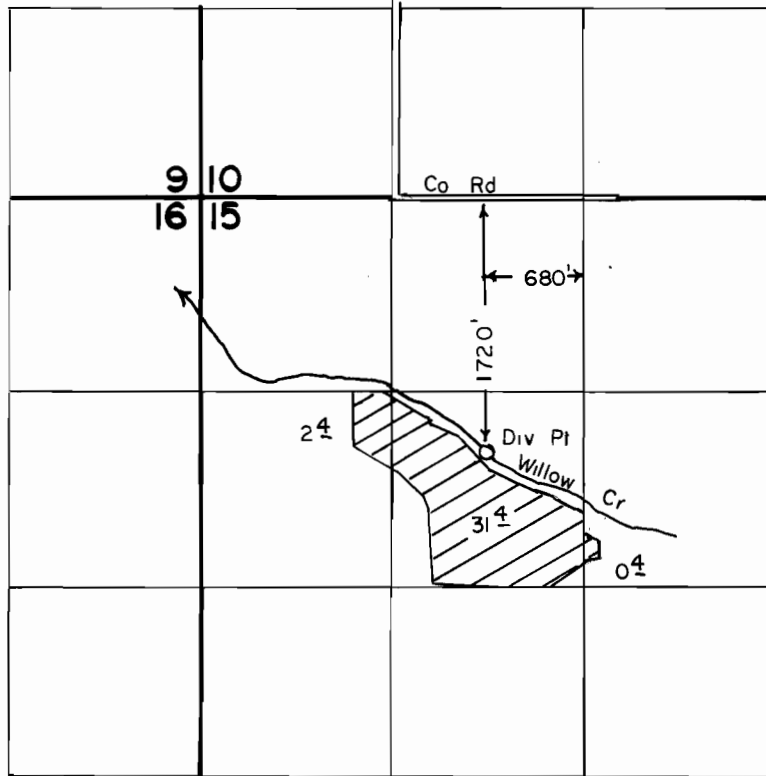

SCALE: 1" = 1320'

**FINAL PROOF SURVEY**  
UNDER

Application No. 57285... Permit No. 44510.....

IN NAME OF

.....LOWELL J. KREUTZER.....

Surveyed JUNE 28, 1988., by B.S. JAMES.....