


T.7S. R.2W. W.M.

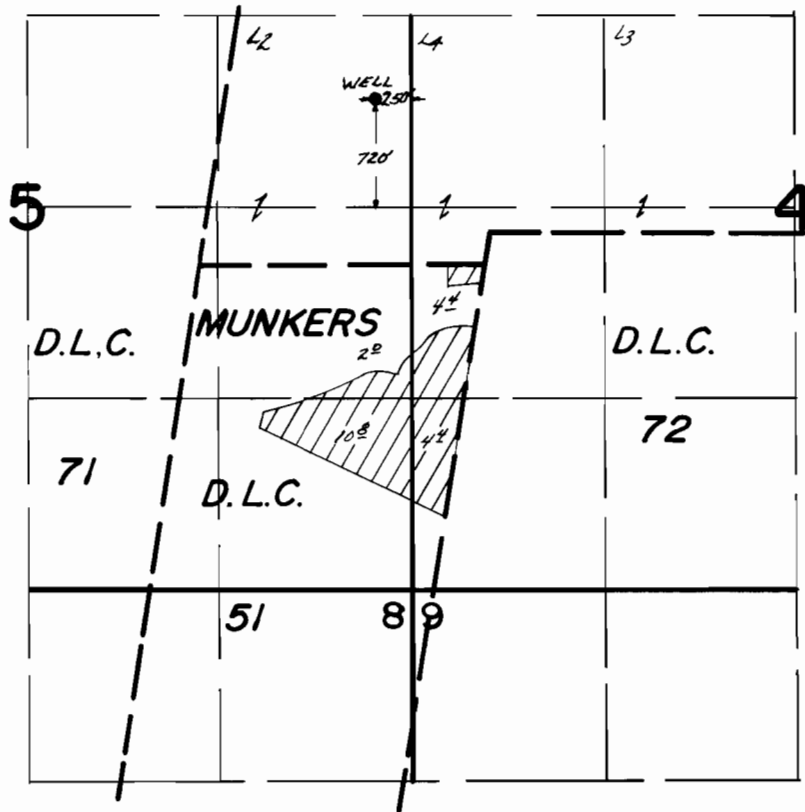


**FINAL PROOF SURVEY**  
UNDER

Application No. G-7850. Permit No. G-7281...  
IN NAME OF

ALVIN SCHWENGEL

Surveyed Sept. 4... 1979, by C.R. RODRIGUEZ.

T.7S.,R.2W.,W.M.

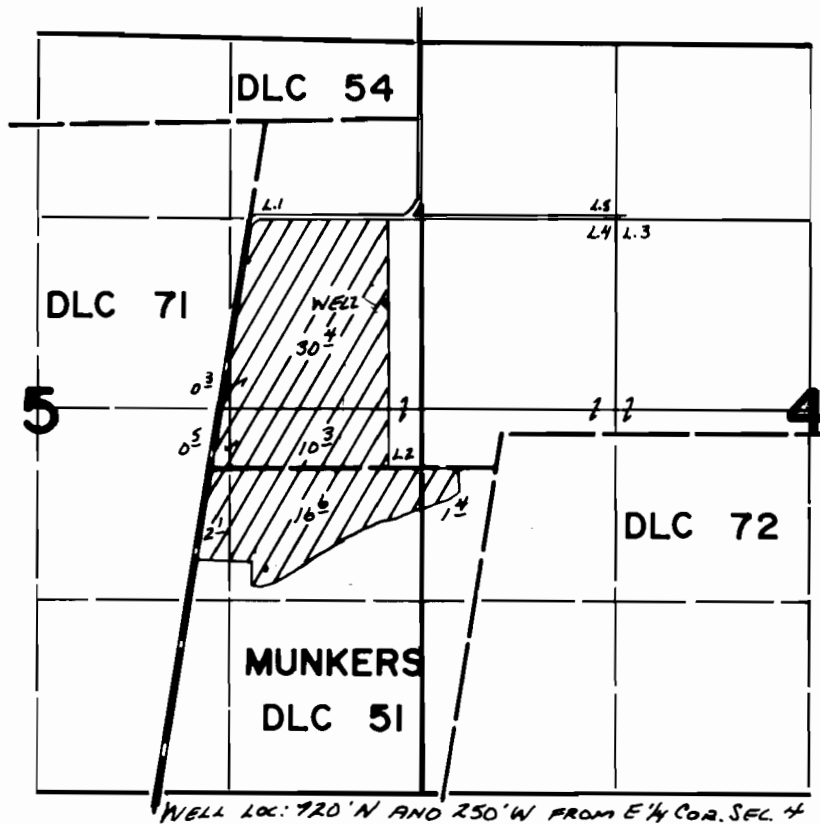

**FINAL PROOF SURVEY**  
UNDER

Application No. G-6155 Permit No. G-5841  
IN NAME OF

NORMAN L. & KAY L. McDONALD

Surveyed May 19 1976, by L. TOLL