


MAP

To accompany the application of Charles H. Robinson for a permit to construct a reservoir.

R-517

6843



2592

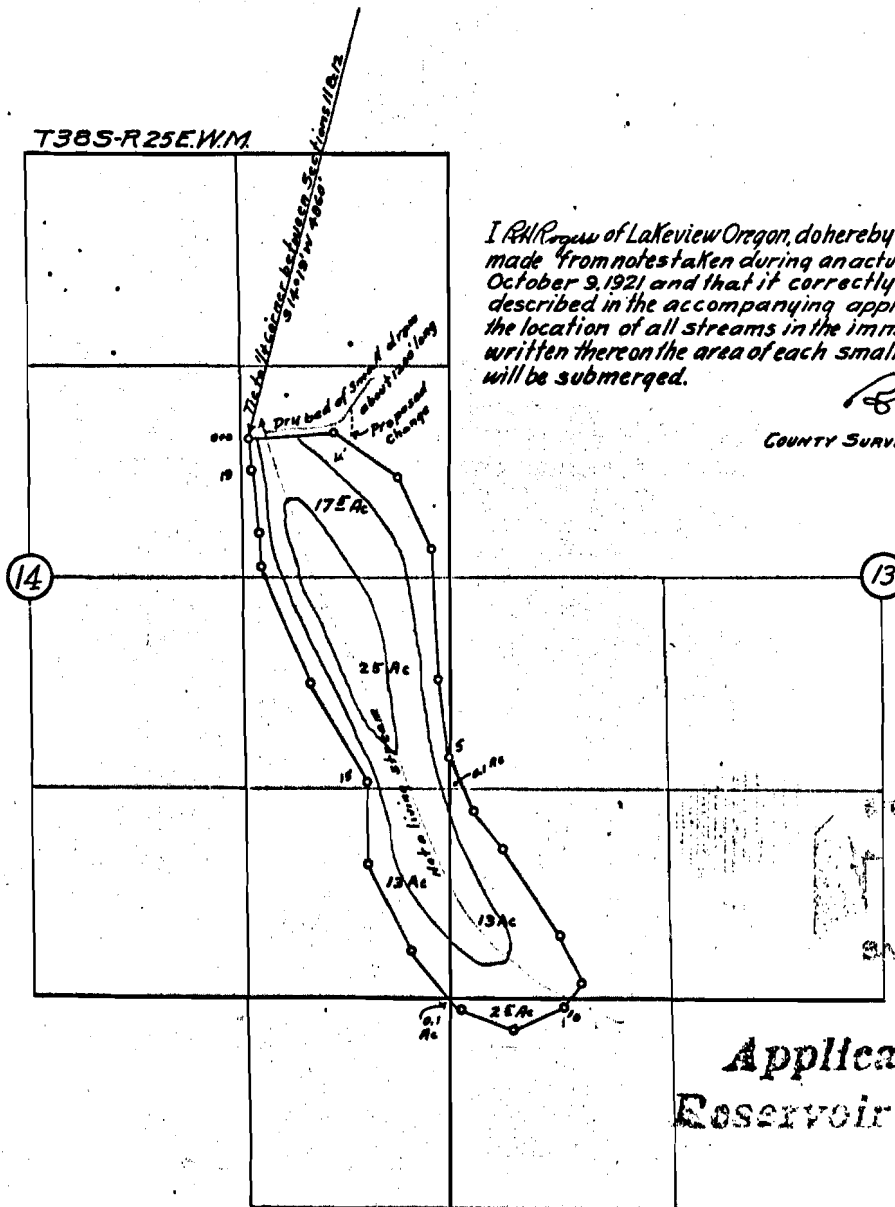

R.H. Rogers.
COUNTY SURVEYOR for LAKE COUNTY OREGON.

OFFICE OF STATE ENGINEER
SALEM, OREGON
OCT 25 1921

Application No. 8138
Reservoir Permit No.

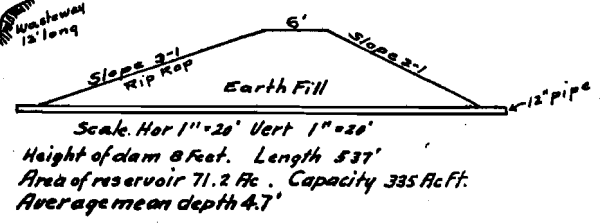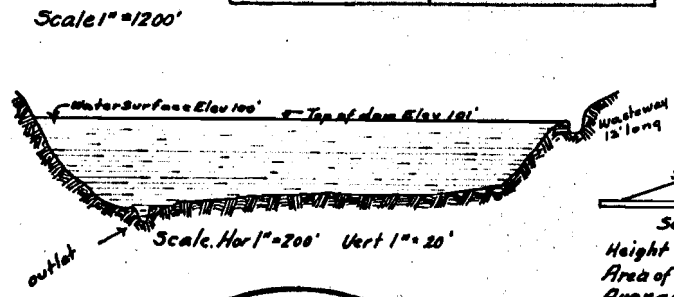

REGISTERED PROFESSIONAL
ENGINEER
789
R.H. Rogers.
OREGON
DEC. 31, 1919
R. H. ROGERS

Application No. 8138
Permit No. R 517

38-25

✓