T. 1 N. R. 3 W.W.M.

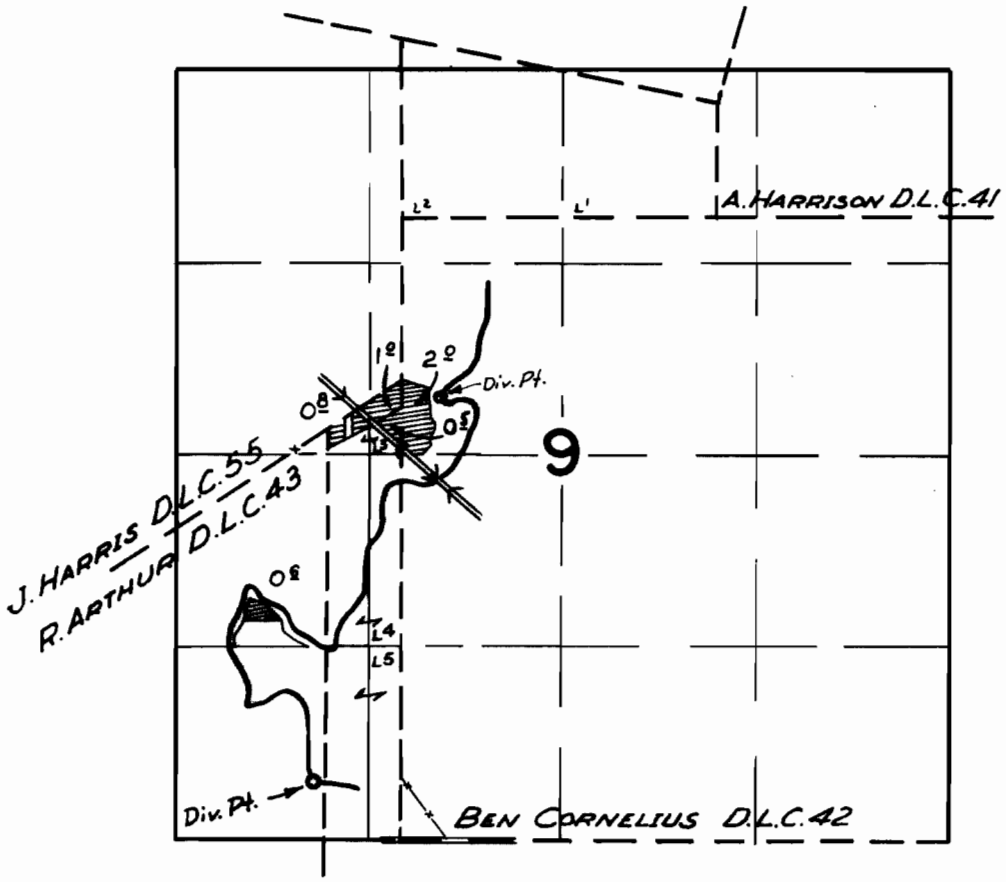

FINAL PROOF SURVEY
UNDER

Application No. 28157 Permit No. 22437
IN NAME OF

ANTHONY F. & MARCELLA G. VANDEHEY

Surveyed APRIL 17 1956, by R. H. WHITBY

DFR-5D-03
1963-1-B