


T.2N.R.4&5W.W.M.

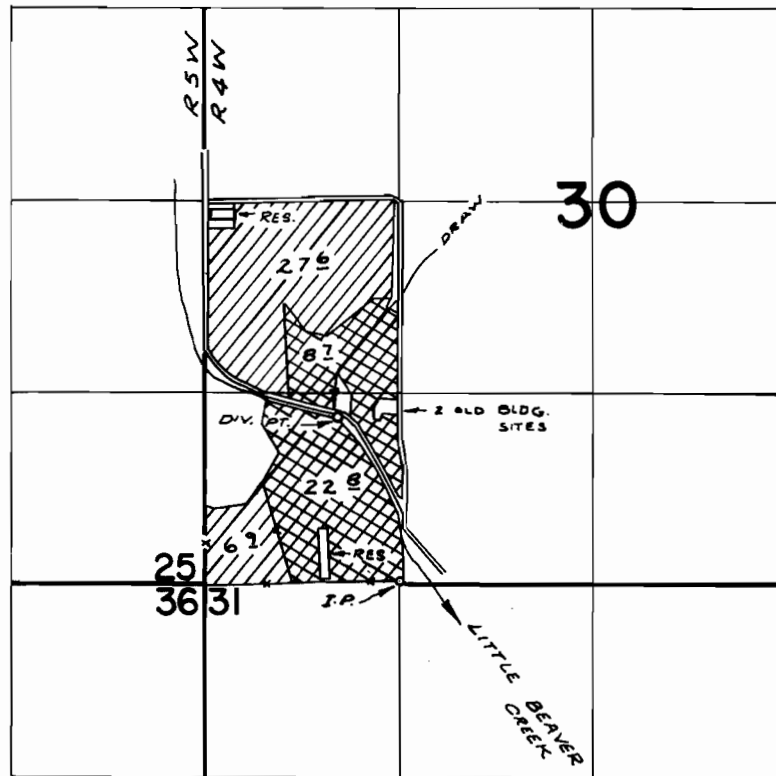

PRIM. PERMIT 33684
SUPP. PERMIT 35685



PRIM. PERMIT 30747
SUPP. PERMIT 33684
SUPP. PERMIT 35685



DIV. PTS. LOC: CREEK - 1150'N & 910'E; RES. - 200'N & 820'E;
2550'N & 120'E; ALL FROM S.W. COR. SEC. 30

FINAL PROOF SURVEY

UNDER

41579
R-45037
45222
R-47666
47929

30747
R-5318
33684
R-5742
35685

Application No. _____ Permit No. _____

IN NAME OF

.....BOBBIE O. SMITH.....

Surveyed SEPT. 28, 1972, by R. MUCKEN