


T.2S.R.IW.W.M.

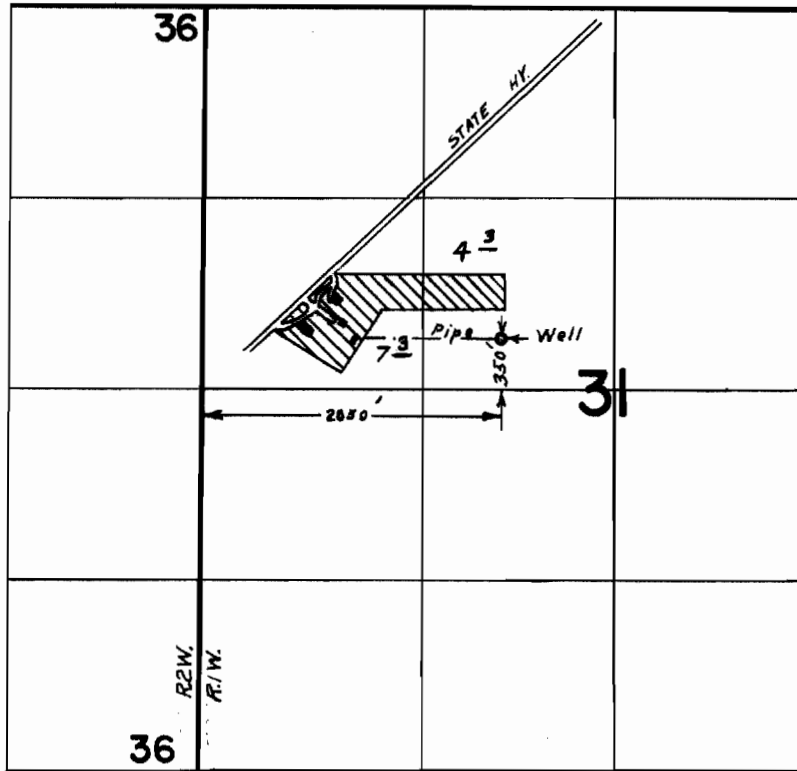

FINAL PROOF SURVEY UNDER

Application No. G-5015 Permit No. G-4694
IN NAME OF

M. KENNETH HOSLER

Surveyed OCT 6 1972, by L. GOULD