


T. 2 N. R. 3 W. W. M.

RECEIVED
JAN 30 1995
WATER RESOURCES DEPT.
SALEM, OREGON

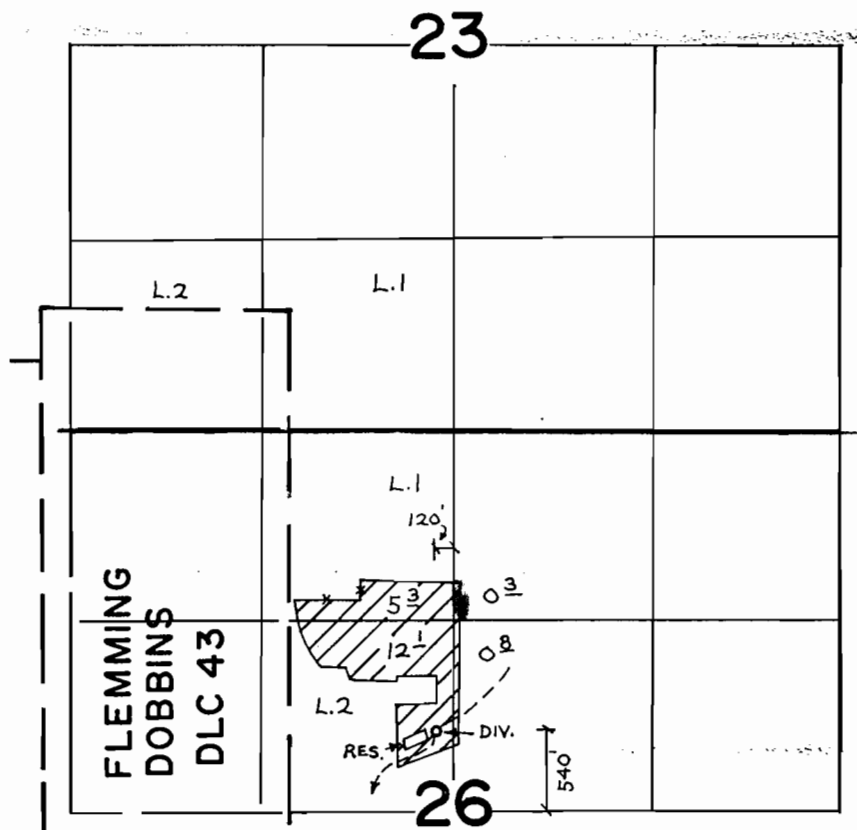

FINAL PROOF SURVEY
UNDER

R-47524 R-5665
Application No. 47115 Permit No. 35278
IN NAME OF
PETER KRAUTSCHEID

Surveyed May 21 1976, by R. G. Mucken