


T. 5 S. R. 1 W. W. M.

T-7013

PLAT 11

AUG 19 1993

WATER RESOURCES DEPT
SALEM, OREGON

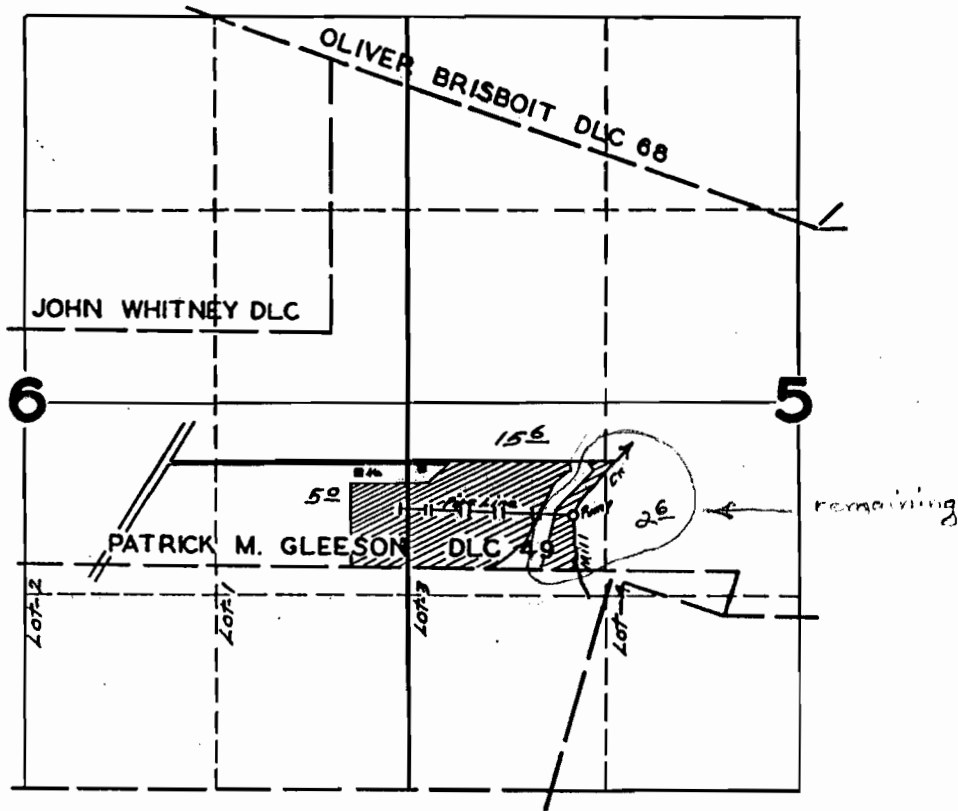

FINAL PROOF SURVEY
UNDER

Application No. 18183 Permit No. 13813 Cert 15078

IN NAME OF
ELMER B. OLSON

Surveyed JUNE 14 1944, by James E. Russell