


T. 25S.,

R. 34E.,

W.M.

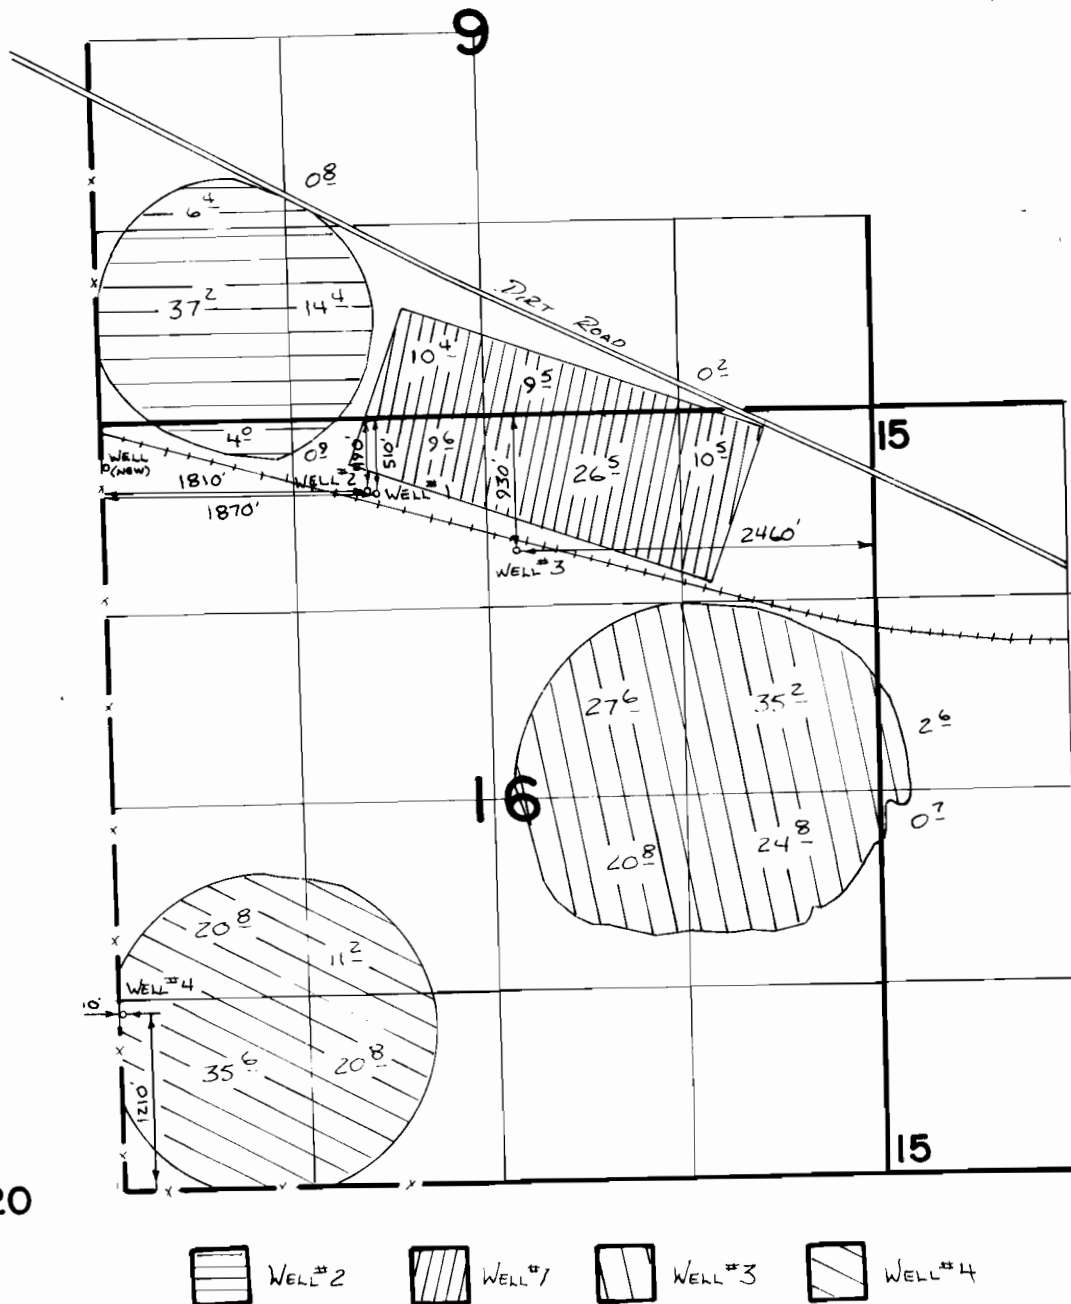

FINAL PROOF SURVEY

UNDER

Application No. **G-10692** Permit No. **G-9814**
IN NAME OF

CANEVARI TIMBER CO. INC.

Surveyed 5-9 1988, by V.L. Church