


T.5S., R.1E., W.M.

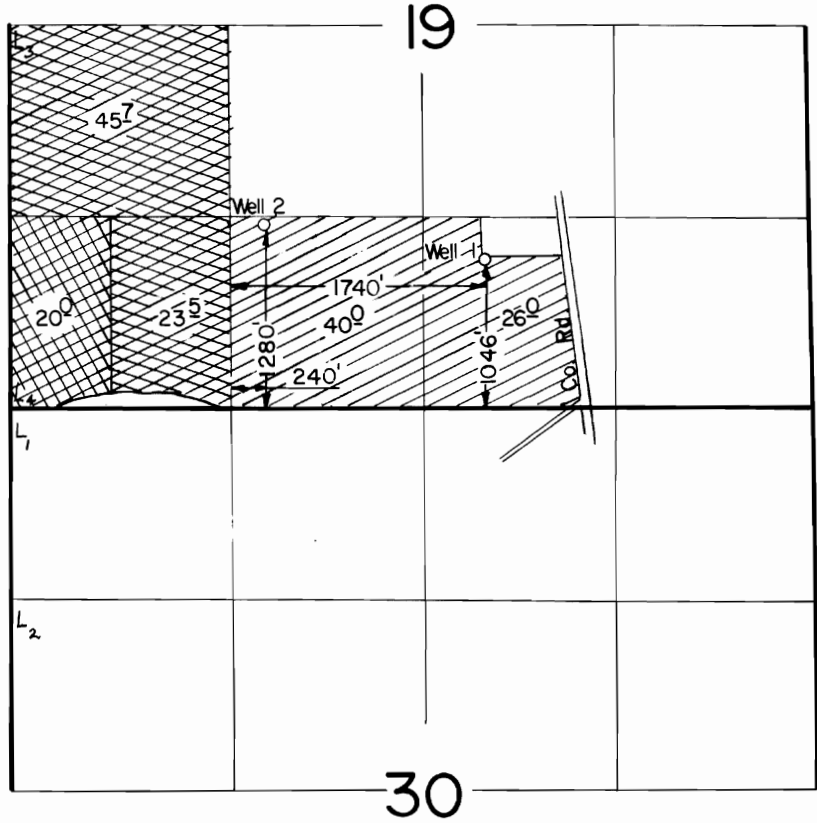

Scale: 1" = 1320'

FINAL PROOF SURVEY UNDER

G- 7830

G- 7272

Application No. G-8882. Permit No. G-8280....

IN NAME OF

RAYMOND GRIESEN AUER

Primary



Supplemental



Surveyed May 22, 1980, by S.C. Brown.....
& June 13, 1985, by T. Warren