
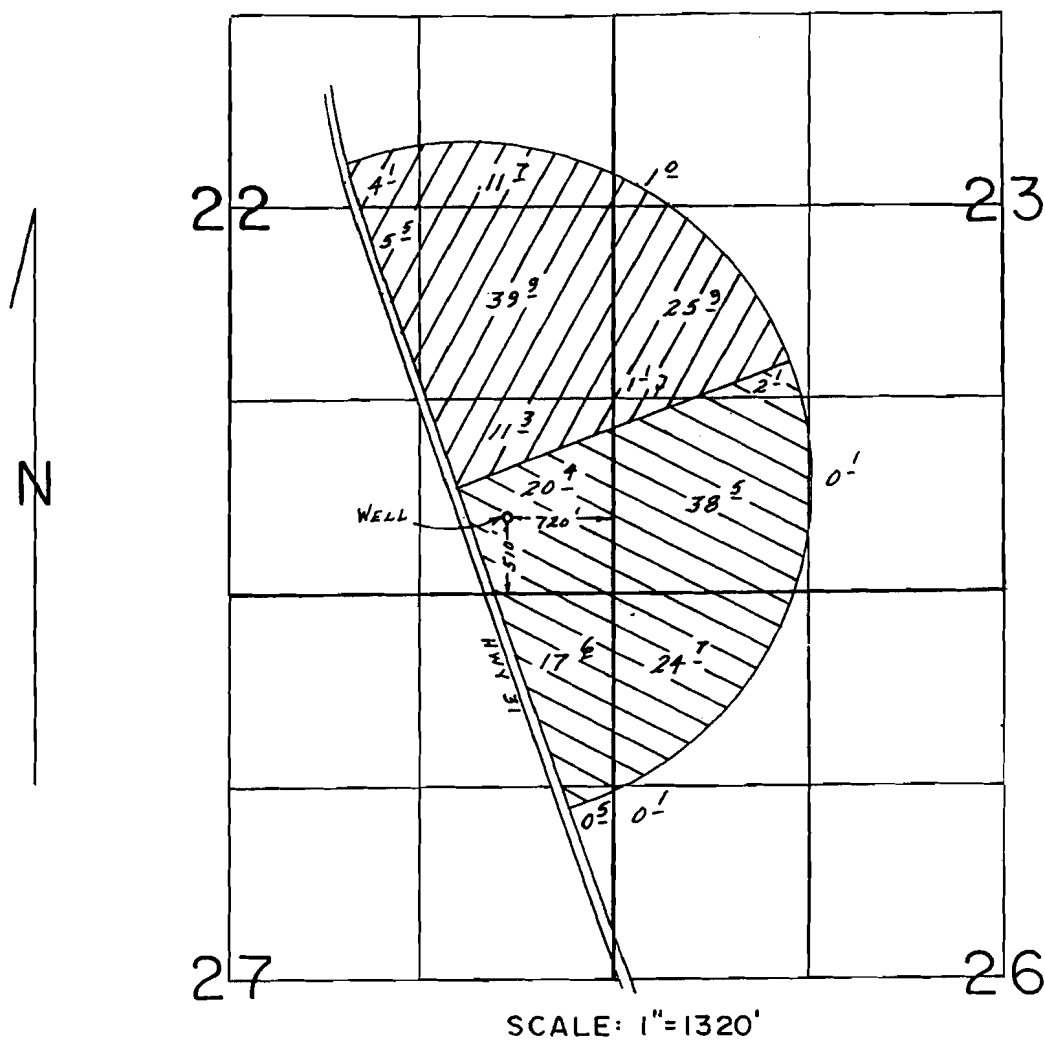
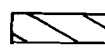


T. 31 S., R. 16 E., W.M.

G-6047
68459

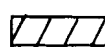

 G-6047
 G-10385

FINAL PROOF SURVEY UNDER

G-6446 G-6047
Application No. G-11270 Permit No. G-10385
IN NAME OF

.....VERLE EMERY.....

Surveyed Dec. 14, 1990, by B.W. BISHOP.....

1-24-91
PTS (41037-479-156R) *Hub*