


T. 31 S., R. 16 E., W. M.

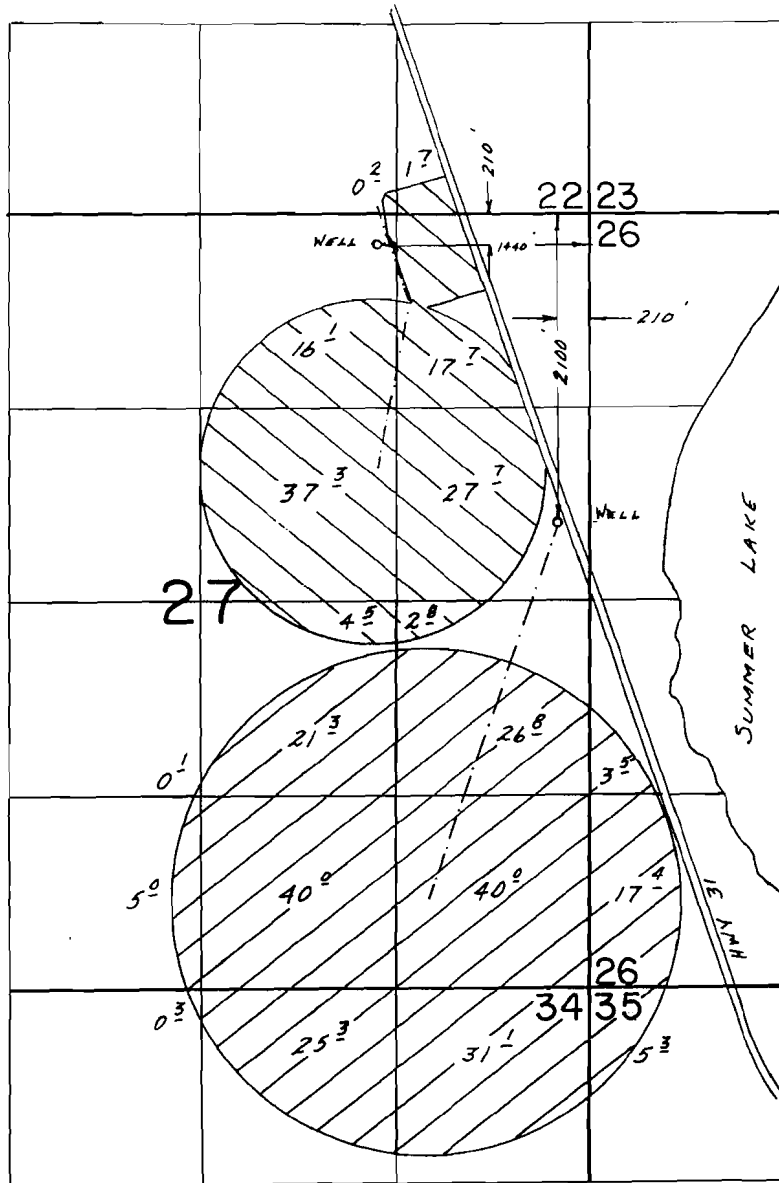

SCALE: 1"=1320'

FINAL PROOF SURVEY

UNDER

G-8348

G-7993

Application No. G-9810. Permit No. G-9028....

IN NAME OF

VERLE EMERY

Surveyed Dec. 14, 1990, by B.W. BISHOP.....

1/22/91 BUB

41037-479-156R