


T. 31 S., R. 16 E., W.M.

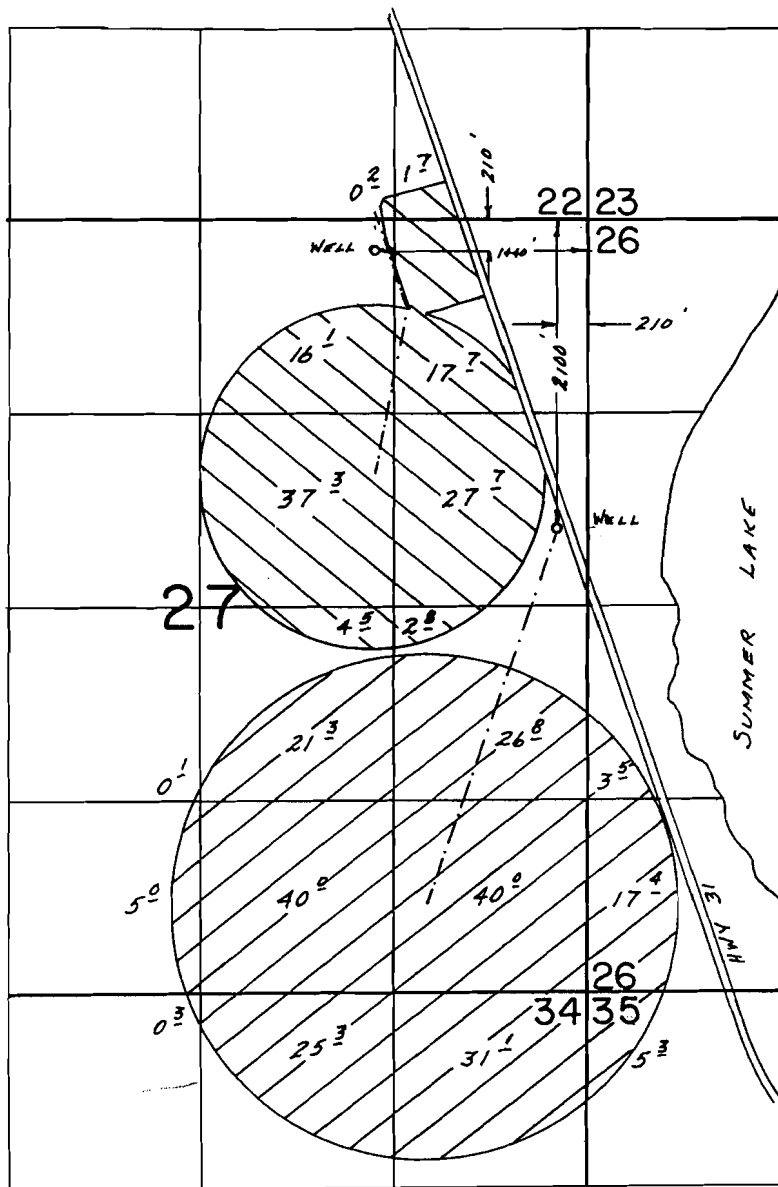

SCALE: 1"=1320'

# FINAL PROOF SURVEY

## UNDER

Application No. G-8348 Permit No. G-7993  
IN NAME OF \_\_\_\_\_

.....VERLE EMERY.....

Surveyed Dec. 14, 1990, by B.W. BISHOP.....

1/22/91 BUB  
41037-479-156R