
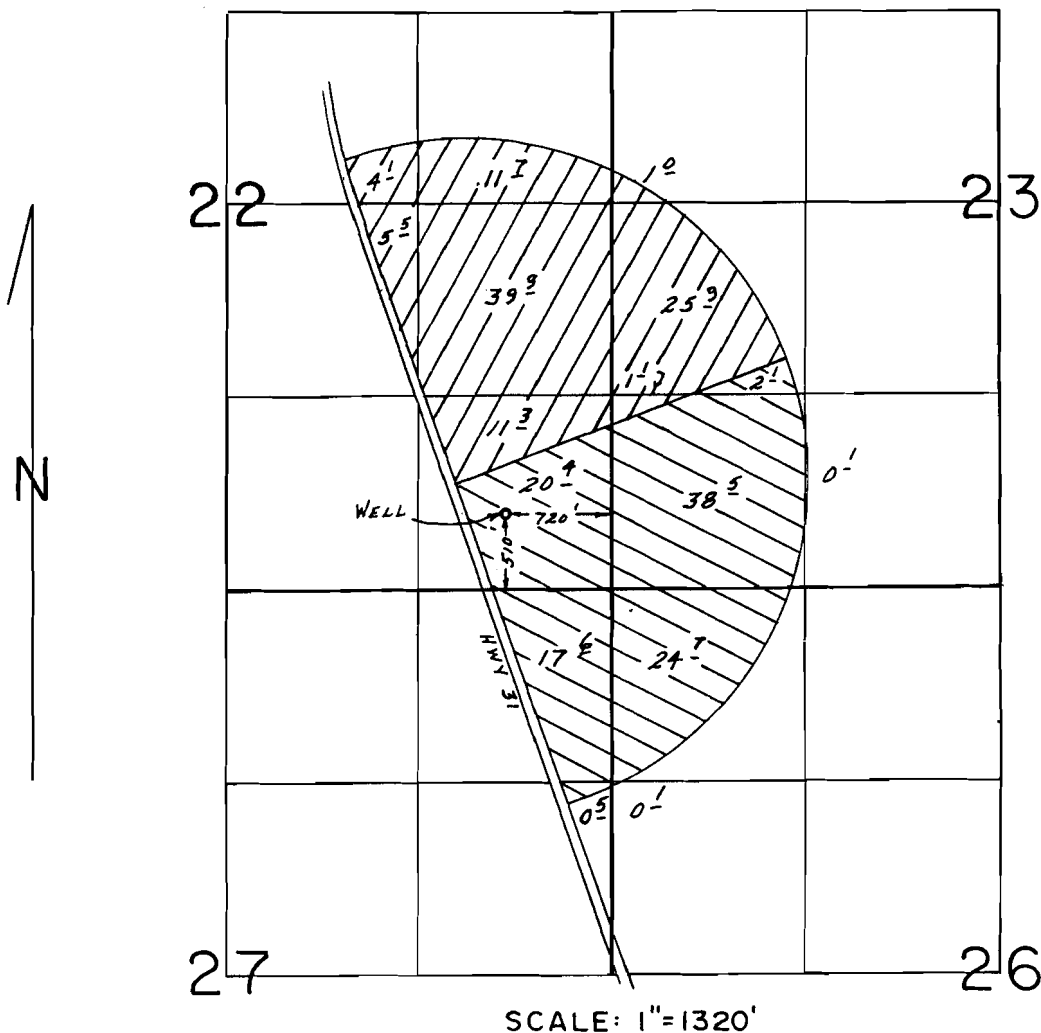


G-10385
68462

T. 31 S., R. 16 E., W. M.

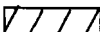

 G-6047
 G-10385

FINAL PROOF SURVEY UNDER

G-6446 G-6047
Application No. G-11270. Permit No. G-10385....
IN NAME OF

..... VERLE EMERY

Surveyed Dec. 14, 1990, by B.W. BISHOP.....