


TOWNSHIP 25 S., RANGE 6 W., W.M.

SECTION 6

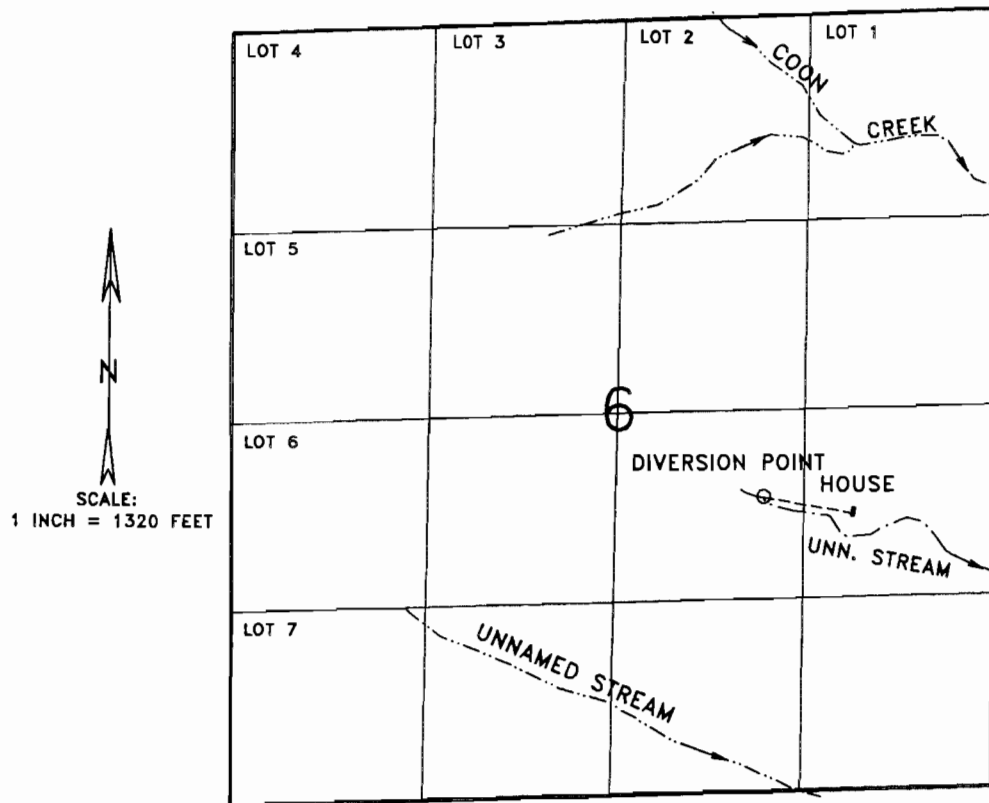

THE DIVERSION POINT IS LOCATED 650' SOUTH & 1600' WEST FROM
THE E1/4 CORNER OF SECTION 6.

FINAL PROOF SURVEY

for

GREGORY G. FOX

APPLICATION 71511

PERMIT 51302

THE PURPOSE OF THIS MAP IS TO IDENTIFY
THE LOCATION OF THE WATER RIGHT. IT IS
NOT INTENDED TO PROVIDE INFORMATION
RELATIVE TO THE LOCATION OF PROPERTY
OWNERSHIP BOUNDARY LINES.

