


# T.9S., R.39E., W.M.

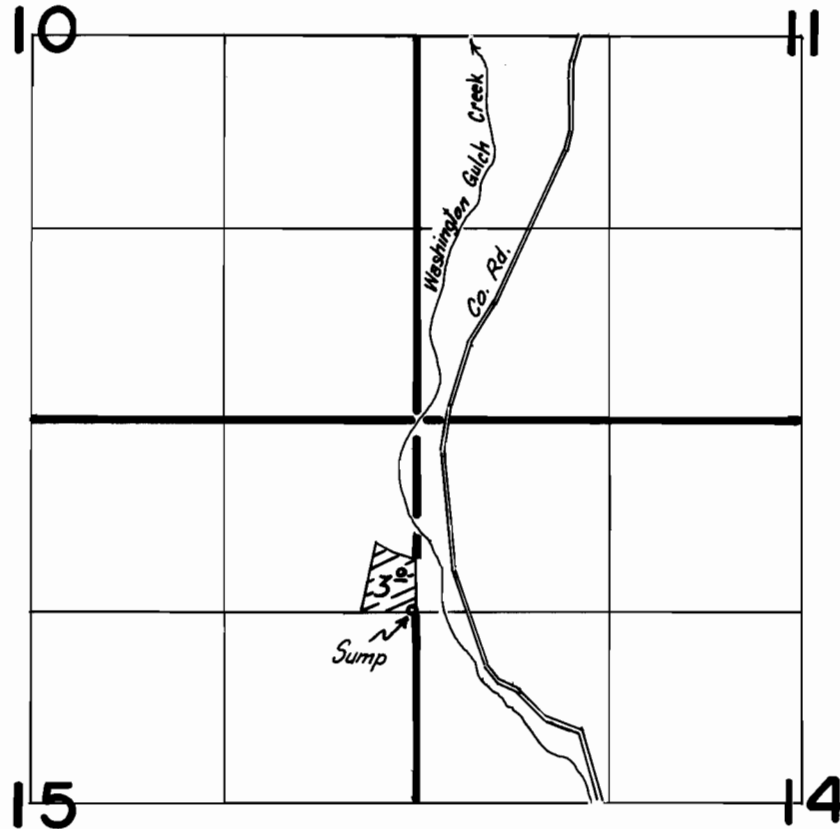

Location of sump is 1310' S. & 20' W. from NE cor. sec. 15.



Scale: 1" = 1320'

## FINAL PROOF SURVEY UNDER

Application No. 58843. Permit No. 44375....  
IN NAME OF

.....SHERMAN R. ALLEN.....

Surveyed ...10-8... 1987, by ..Vern Church.....