


T.39S.,R.11 1/2E.W.M.

G-4555
68471

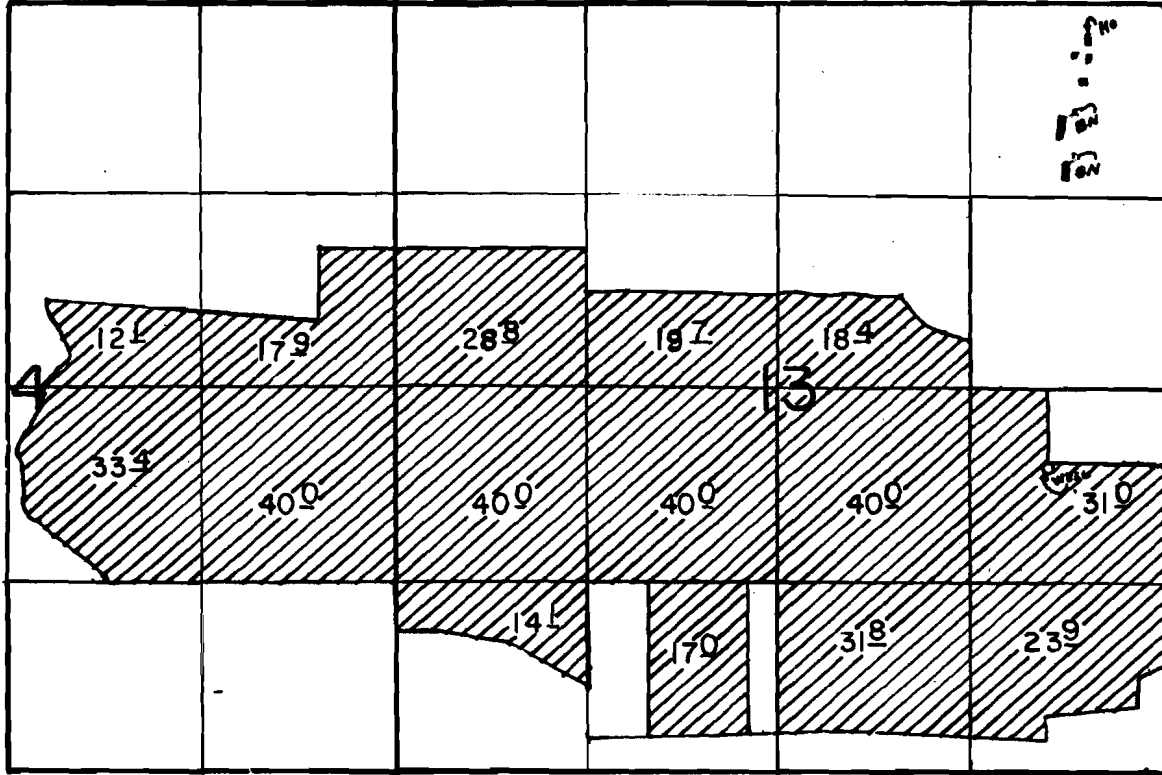

WELL LOC. 2080'N & 780'W FROM SE COR. OF SEC 13.

SCALE: 1" = 1320'

FINAL PROOF SURVEY
UNDER

Application No. G-4832 Permit No. G-4555...
IN NAME OF

...ALBERT R. & BETTY F. HUNT...

Surveyed JUNE 7, 1994, by R.M. SUTTERFIELD

East River Well