


T. 35 S., R. 2 W., W. M.

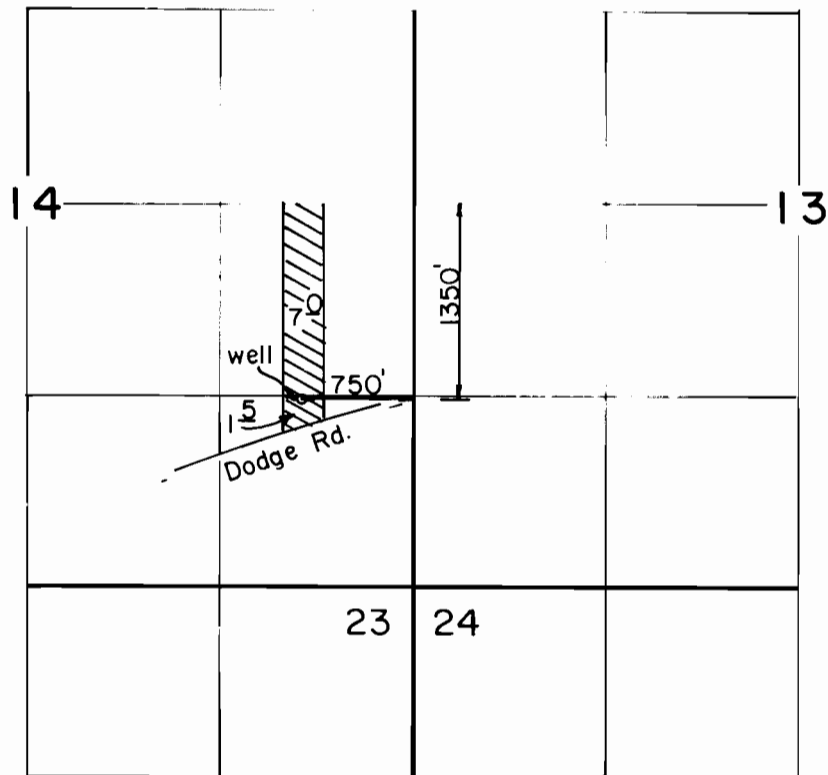

Scale: 1" = 1320'

FINAL PROOF SURVEY
UNDER

Application No. G:115.75 Permit No. G:1Q688.
IN NAME OF

.....GREGORY SCOTT BAFORD.....

Surveyed JULY 3, 1991, by R. S. JAMES.....