


SEC's. 8 & 17, TWP. 1 S. RANGE 14 E. W.M.
 WASCO COUNTY, OREGON

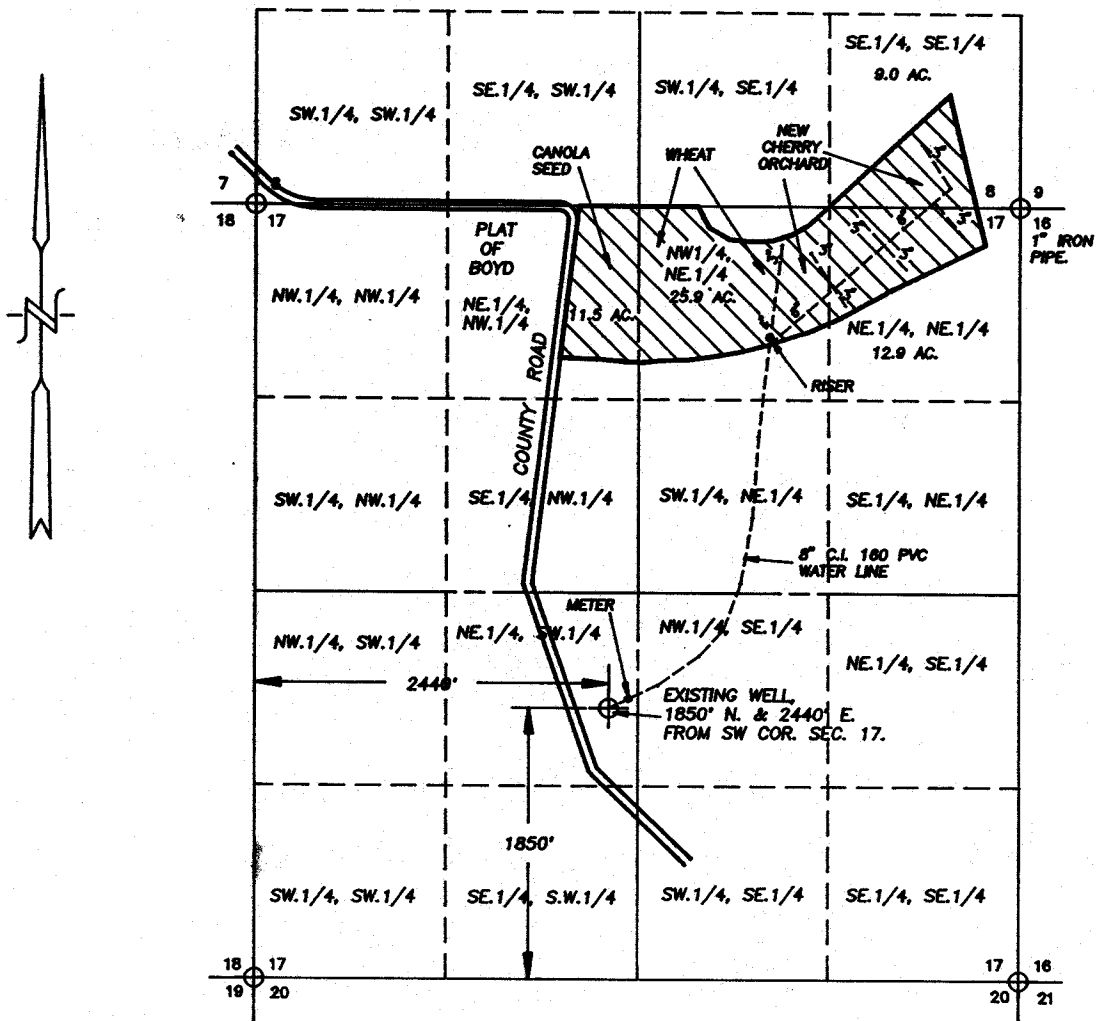

FINAL PROOF SURVEY

SCALE: 1" = 1320'


APPLICATION No. G-12099

PERMIT No. G-11071

IN THE NAME OF:
DANIEL L. BOLTON

DATE: SEPTEMBER 16, 1992

BY: TENNESON ENGINEERING CORP.
 409 LINCOLN STREET,
 THE DALLES, OREGON. 97058
 PH. (503) 296-9177

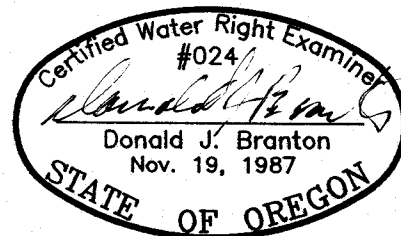

NOTE:

"THIS MAP IDENTIFIES THE LOCATION OF THE WATER RIGHT ONLY AND IS NOT INTENDED TO PROVIDE DIMENSIONS OR LOCATE PROPERTY OWNERSHIP LINES.

W.O. #7379