


T. 8 S., R. 45 E., W.M.

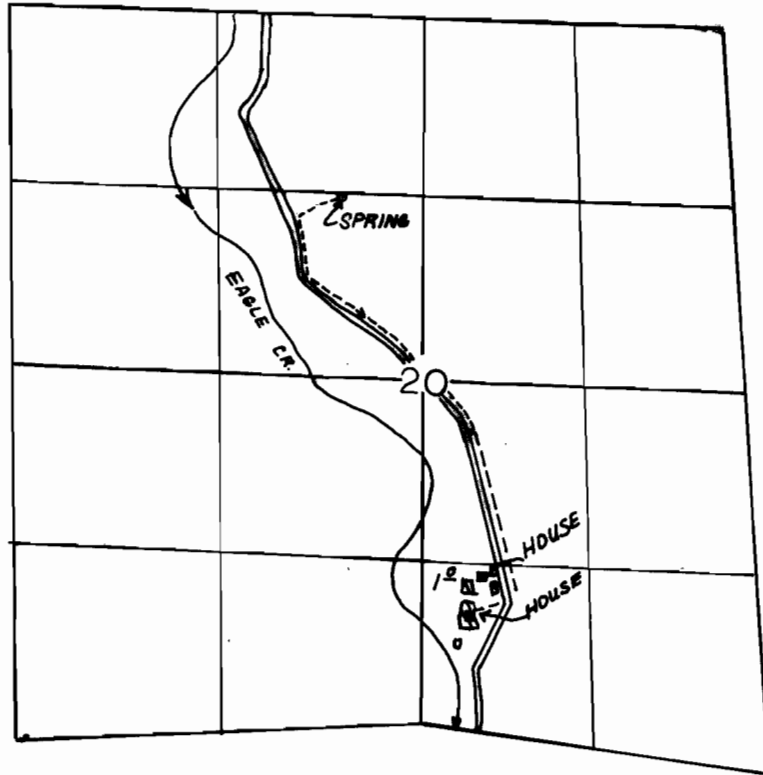

1" = 1320'

POD - 1250' N. AND 550' W. FROM CENTER COR. SEC. 20.

FINAL PROOF SURVEY

UNDER

Application No. 61164 Permit No. 46941

IN NAME OF

PEGGY J. ANDERSON

Surveyed 4-5, 1994, by J. MILLER