


49753
68477

T. 39 S., R. 4 E., W. M.

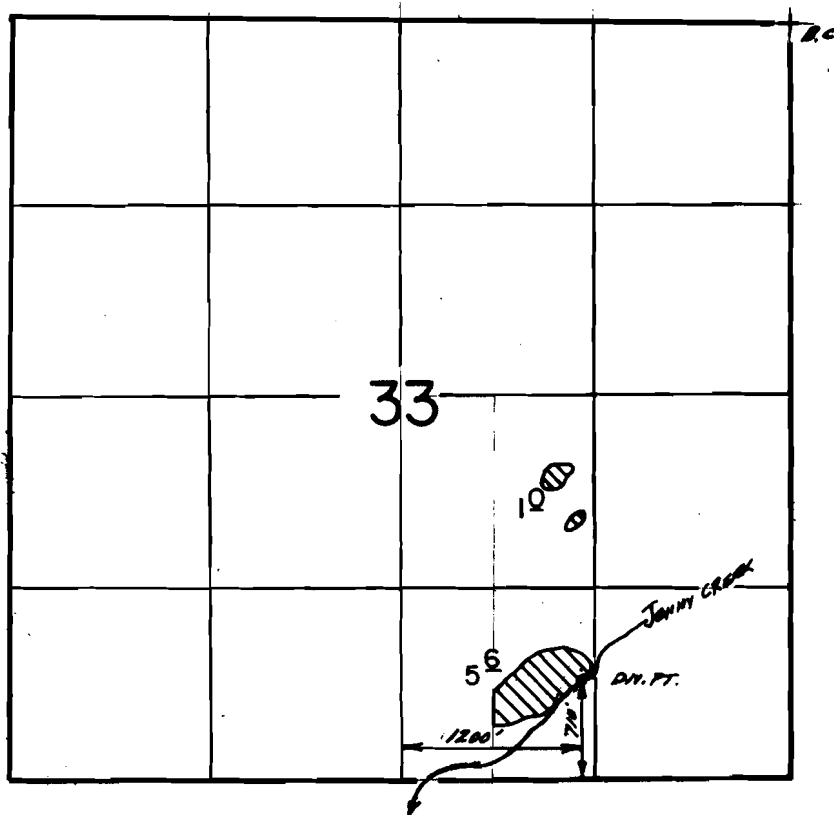

Scale 1" = 1320'

FINAL PROOF SURVEY
UNDER

Application No. ~~68748~~ Permit No. 49753....
IN NAME OF

ANTHONY....HENTHORN...&...WENDY S. FULLERTON

Surveyed July 30 1991, by S. James.....