



T. 29 S., R. 11 W. W. M.

Map 1 of 2

Section 28

Scale: 1" = 400ft.

Disclaimer: This map is not the result of a property survey and is not to be used as such.

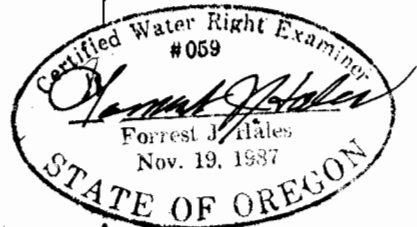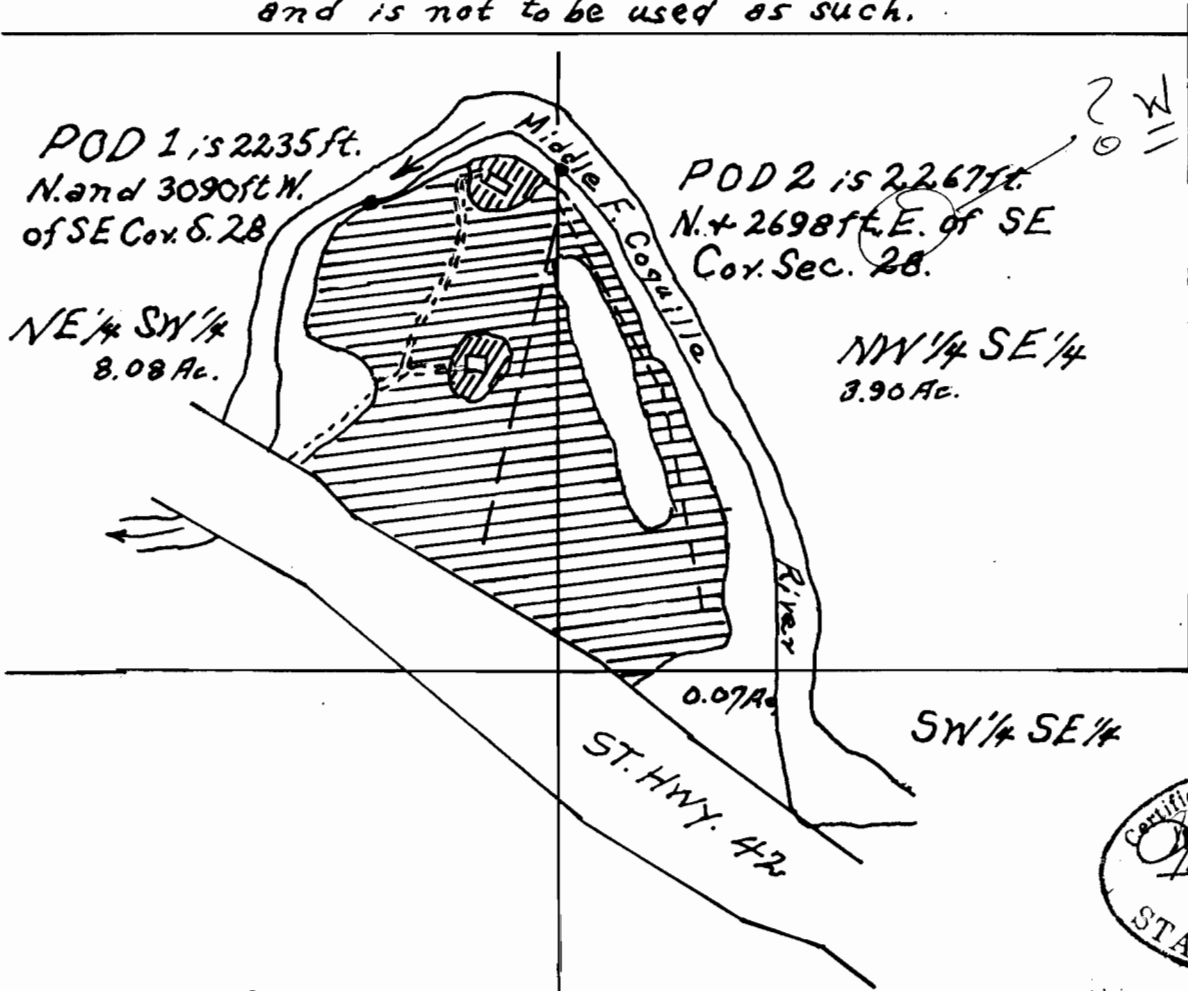

FINAL PROOF SURVEY

Under

Application No. 70201

Permit No. 51179

In the name of

Steven R. and Mylissa Cooper

Surveyed Aug. 22, 1992 by F. J. Hales

T. 29 S., R. 11 W. W. M.

Map 2 of 2

Section 28

Scale: 1" = 1320ft.

