


T.5S. R.33E., W.M.

P-46480  
C-68479

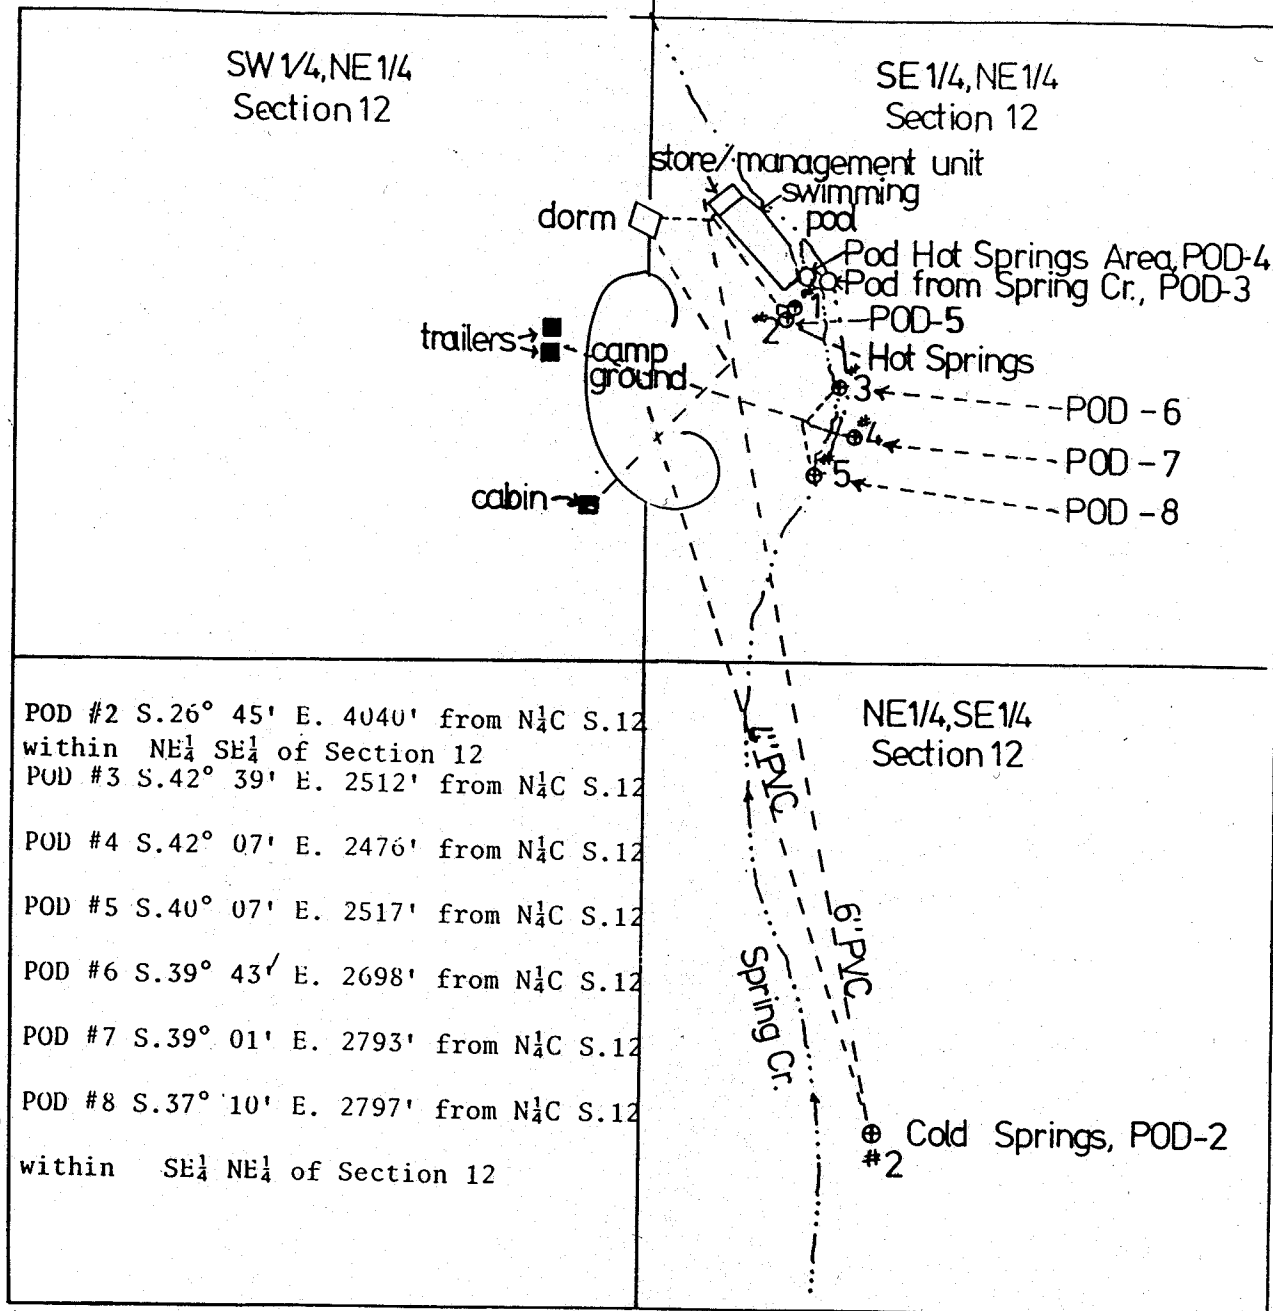

# FINAL PROOF SURVEY UNDER

Application No. 61953. Permit No. 46480.  
IN NAME OF

JOHN WHITESELL

Surveyed 8-28-1991, by J. Miller

Drafted  
2-3-92  
J. Miller