


T. 11 S., R. 10 W., W.M.

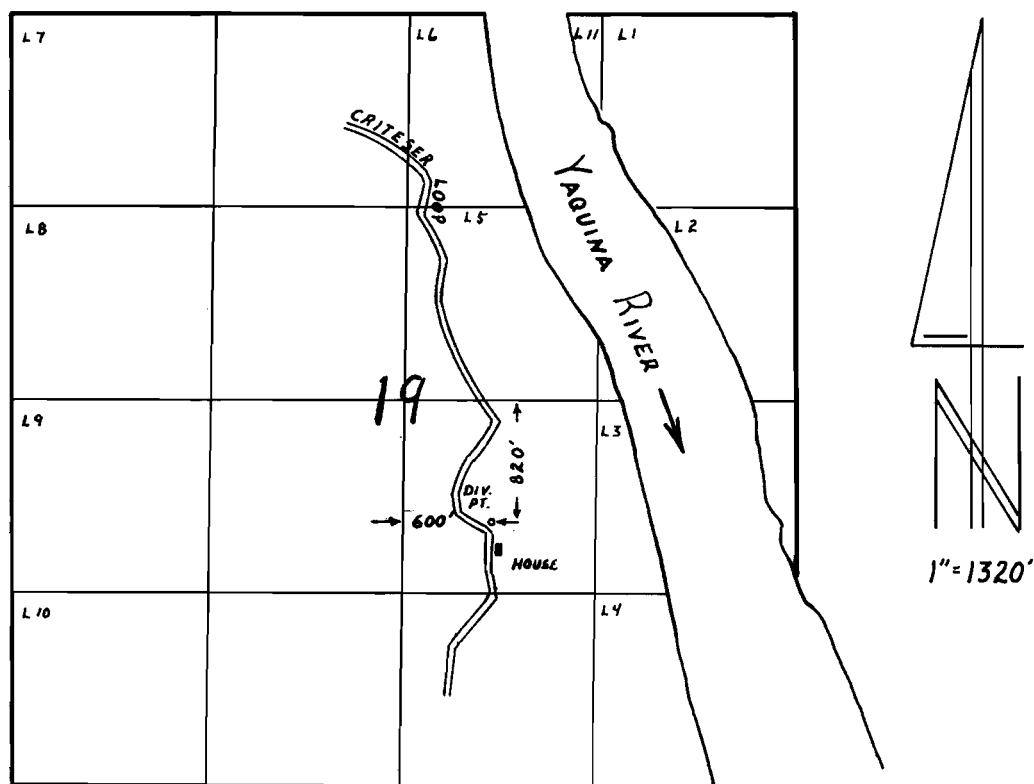

FINAL PROOF SURVEY UNDER

Application No. 49907 Permit No. 37928
IN NAME OF

RANDY & MORAY REID

Surveyed JULY 13, 1992, by R.W. Klassen