
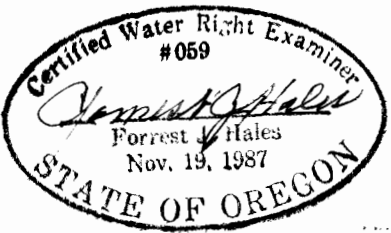


T. 26 & 27 S., R. 11 W. W.M. FINAL PROOF SURVEY

Scale: 1" = 400 ft.

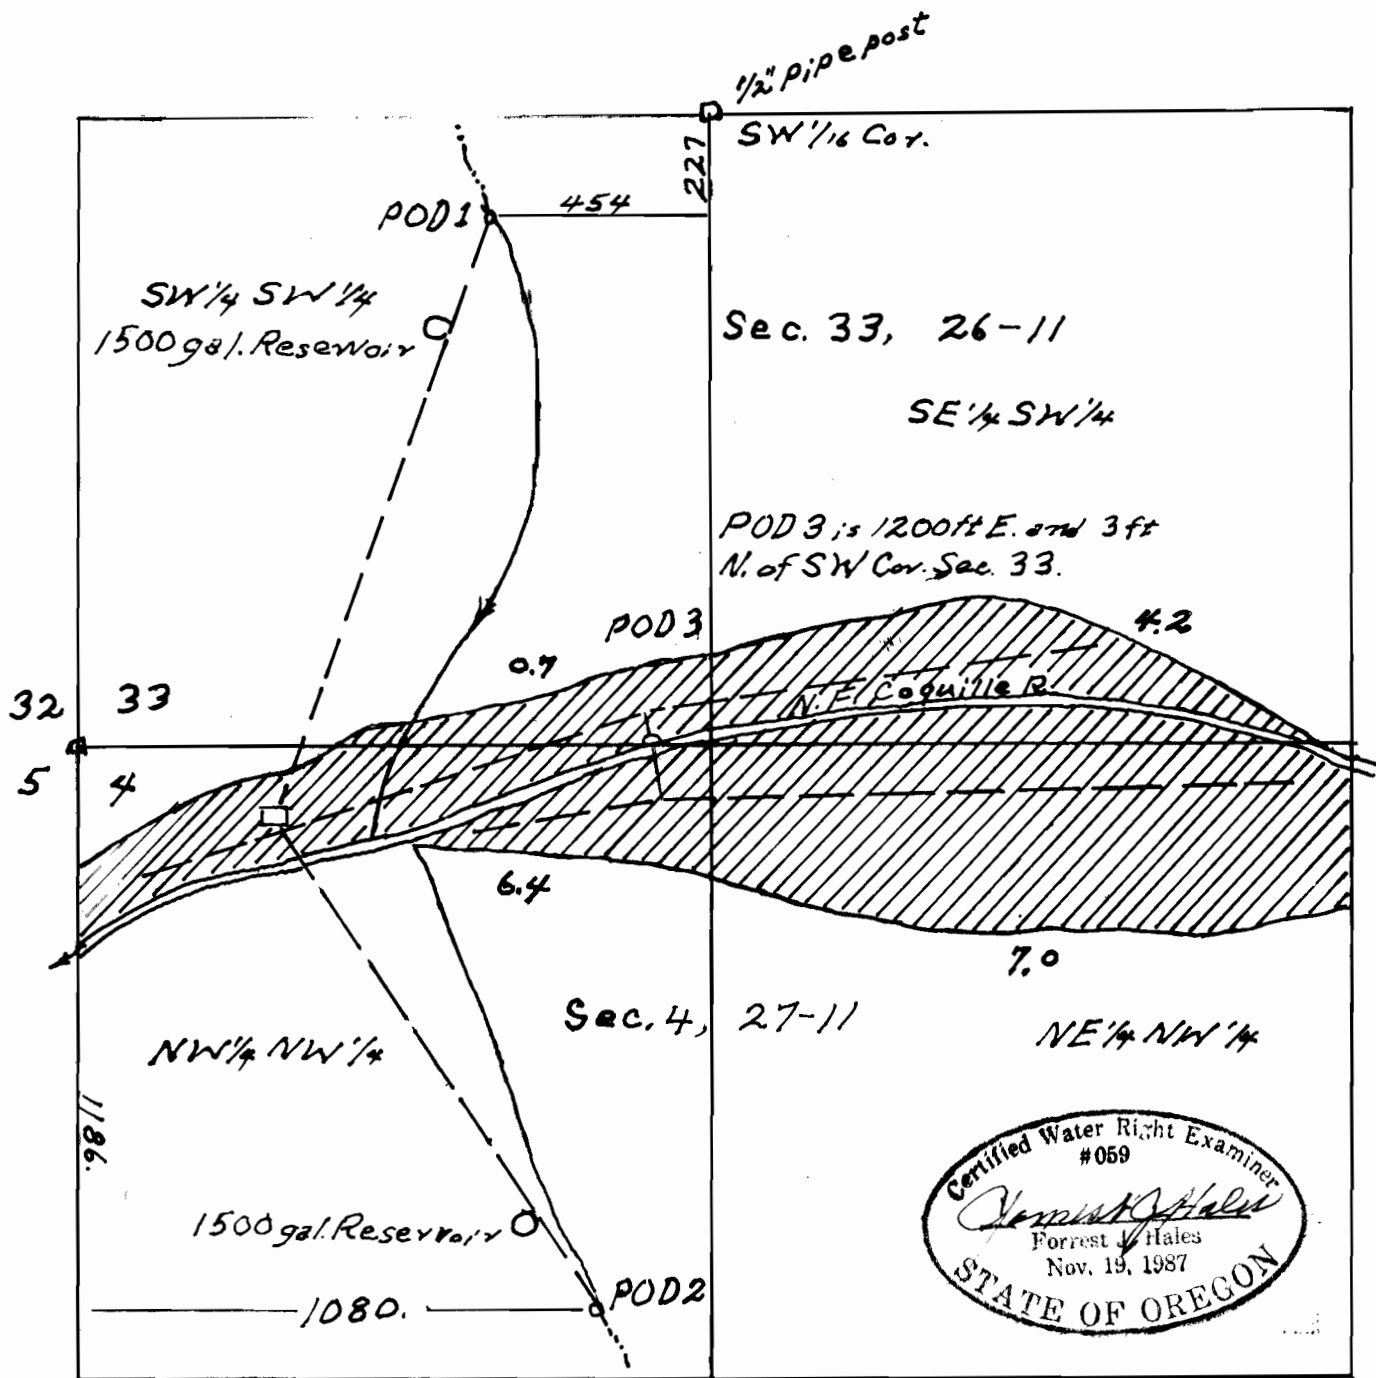

Application No. 69738

Permit No. 50924

Surveyed March 24, 1992 by Forrest J. Hales No. 59

This map is not the result of a property survey and is not to be used as such.