


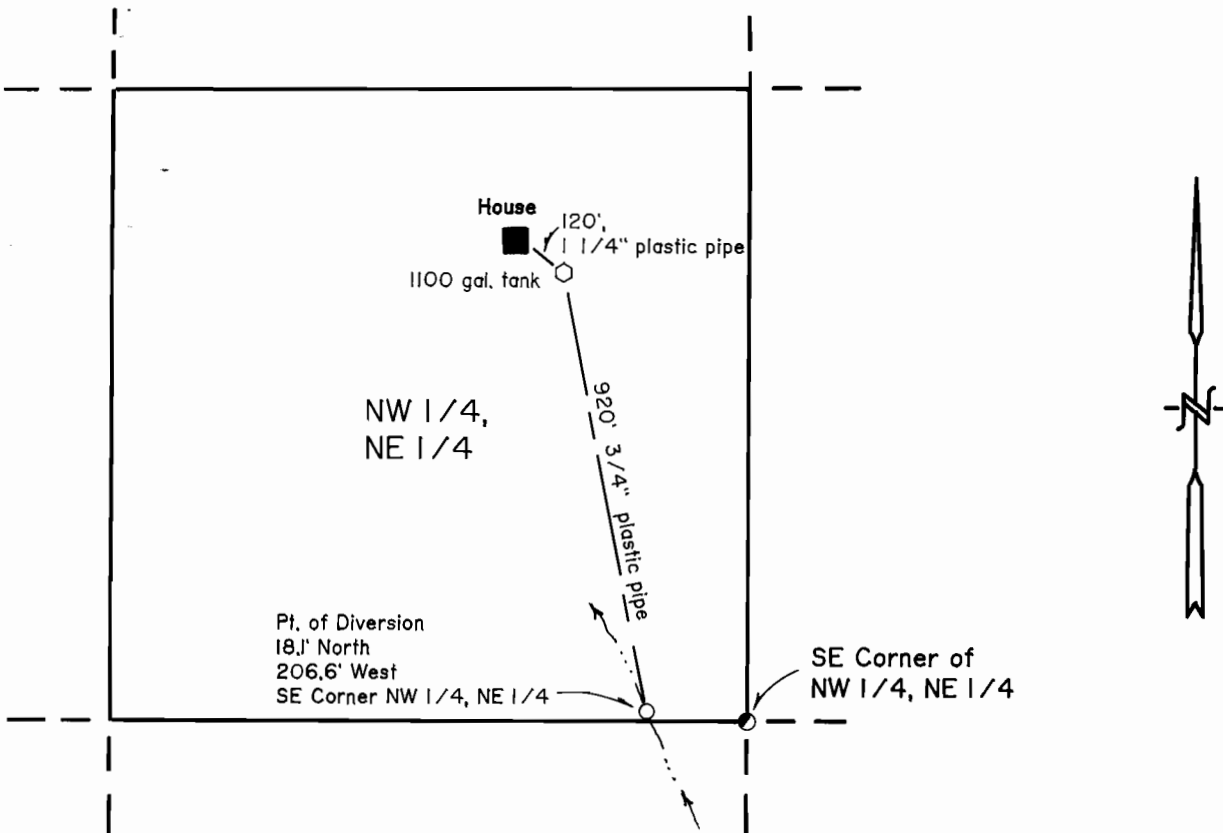

The preparation of this map was for the purpose of identifying the location of the proposed water right and has no intent to provide dimensions or location of property lines.

T. 36 S., R. 14 W., W.M.

Section 36

FINAL PROOF SURVEY

UNDER

Application # 71541 Permit # 51307

IN THE NAME OF

MARK FURLER & PEG REAGAN

Surveyed August 13, 1992, by H.J. Newhouse

Scale 1" = 400'

