


T. 37S., R. 6 W., W.M.

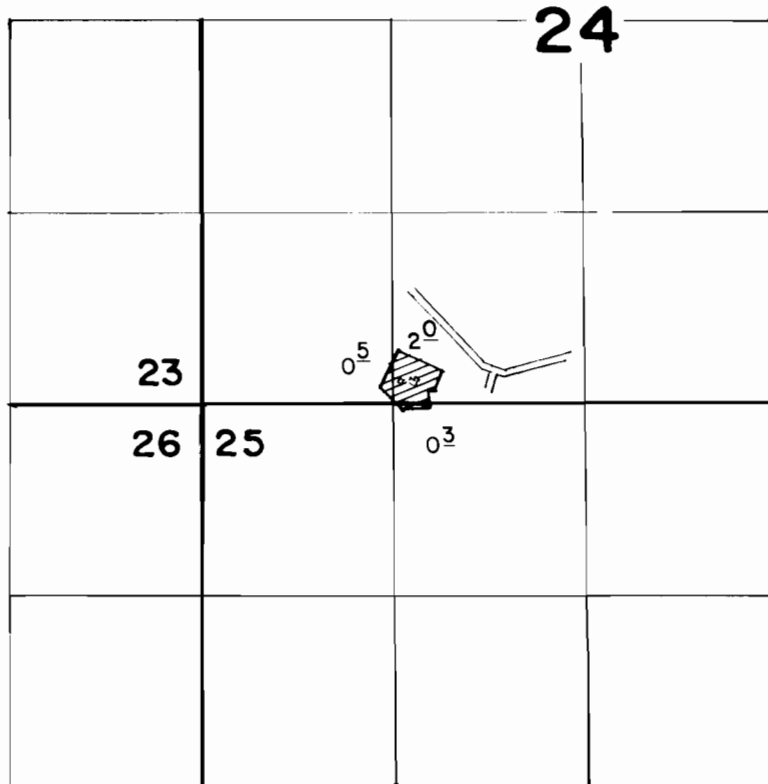

DIVERSION: IRON CREEK DITCH - 1540' S & 1020' W from
N/4 cor Sec 25

FINAL PROOF SURVEY
UNDER

TRANSFER NO. 3767

IN NAME OF

MALCOMB C. BLACKHALL.....

Surveyed JUNE 16, 1982., by ...B. R. SUND.....