


T. 16 & 17 S., R. 3 W., W.M.

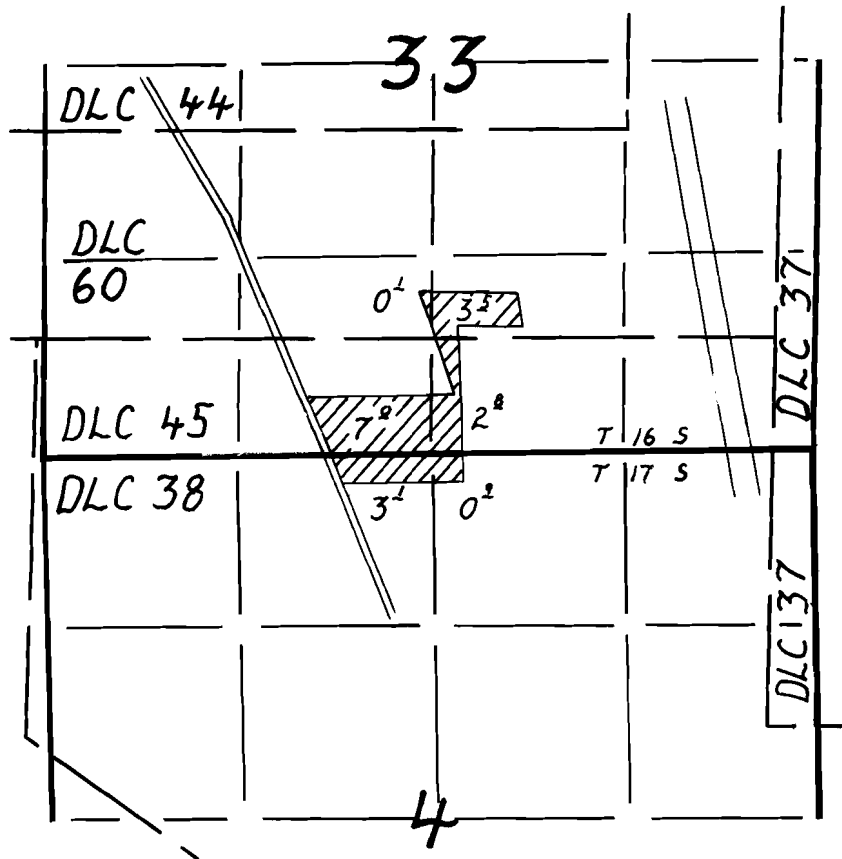

FINAL PROOF SURVEY

UNDER

Application No. 68824 Permit No. 50921

IN NAME OF

MUDDY CREEKS IRRIGATION PROJECT

Surveyed 1993 by R.W. Klassen