


T.6S., R.2W., W.M.

ESP 01

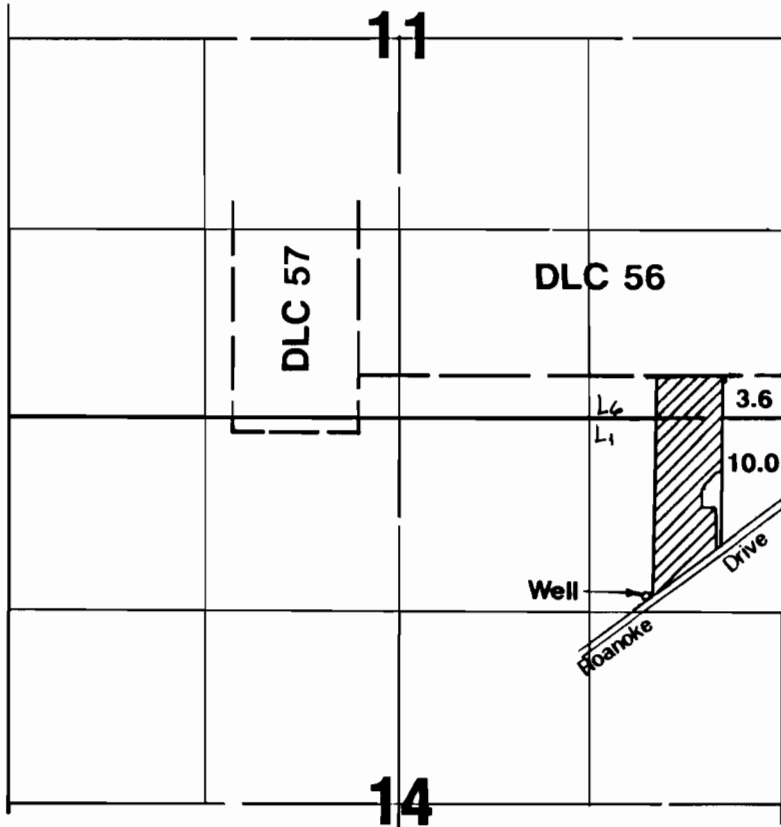

Well located 1193'S & 935'W from NE Corner Section 14.


### Final Proof Survey

Application #: G-11799      Permit #: G-10918

UNDER

### Clayton McCullough

Surveyed 11-29-89 by JMS

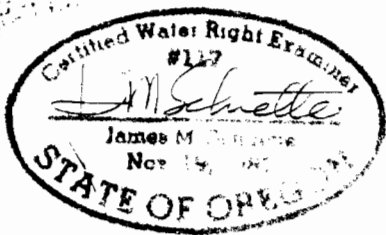

NOTE: Map is for the purpose of identifying location of water right and has no intent to dimension or locate property ownership lines.