


CERTIFICATE:


I, ANTHONY C. KLEIN, THE WITHIN REGISTERED WATER RIGHT EXAMINER DO HEREBY CERTIFY THAT THIS MAP WAS PREPARED BY ME AND IS FOR THE PURPOSE OF IDENTIFYING THE LOCATION OF THE WATER RIGHT ONLY AND HAS NO INTENT TO PROVIDE DIMENSIONS OR LOCATION OF PROPERTY OWNERSHIP LINES.

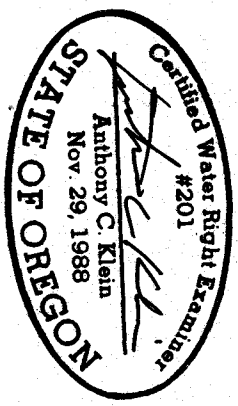

FINAL PROOF SURVEY
FOR

RICHARD KENWARD

PERMIT #51104

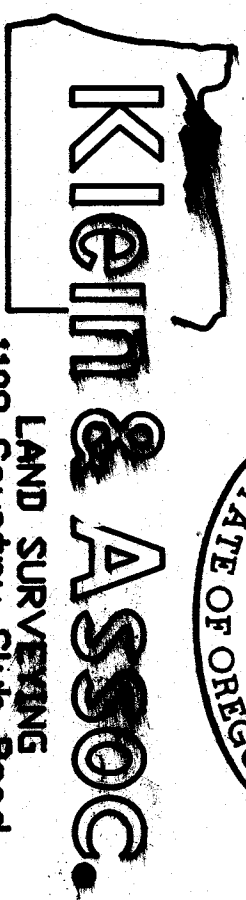

LAND SURVEYING
1109 Country Club Road
Hood River, Oregon 97031
Tele: (503)386-3322

DATE: NOV 1992

App# 70242

Amended 7/16/93 - Show Acreage by 40s JOB NO.: 90004

RECEIVED

DEC 04 1992

WATER RESOURCES DEPT.
SALEM, OREGON

FINAL PROOF SURVEY

IN SECTION 16, T 2 N, R 10 E, **WN**
COUNTY OF HOOD RIVER, STATE OF OREGON

RECEIVED

JUL 22 1993

WATER RESOURCES DEPT.
SALEM, OREGON

