


# T. 12 S., R. 44 E., W.M.

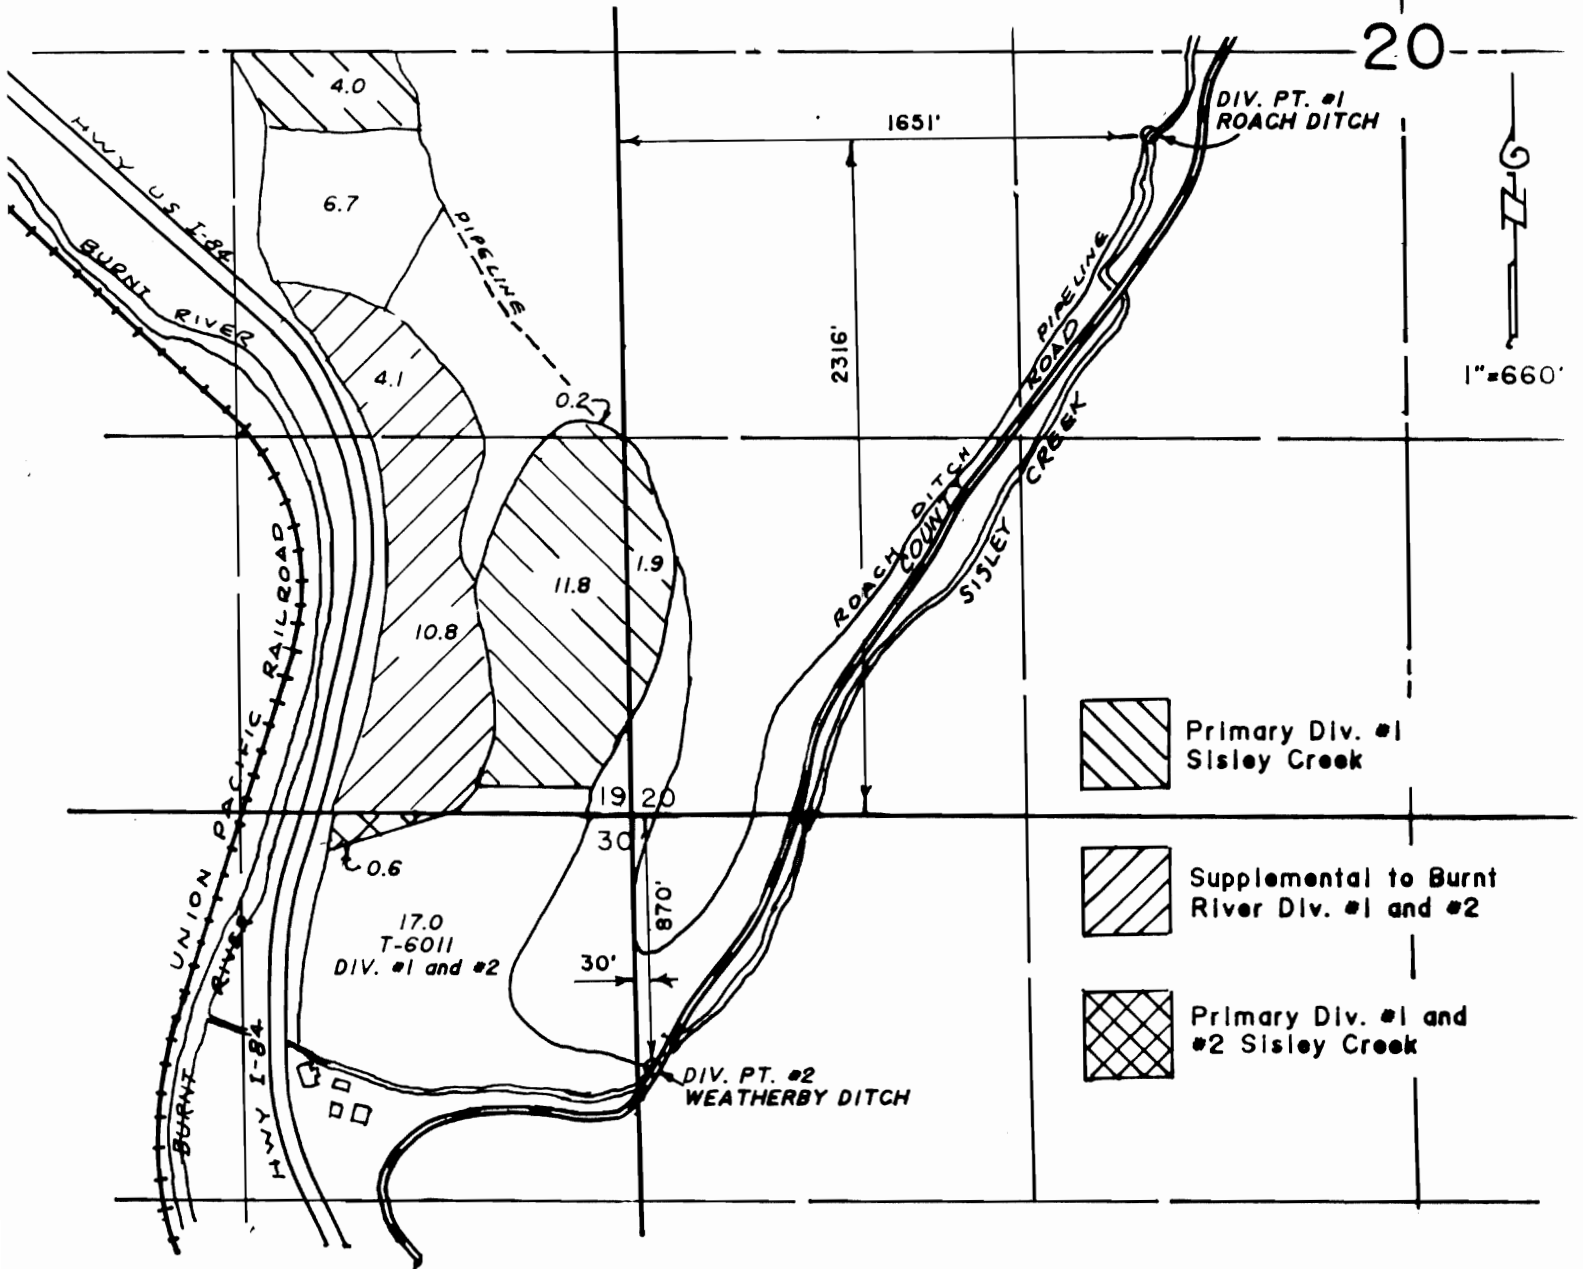

## FINAL PROOF SURVEY

UNDER

T-6011  
Application No. 69421..... Permit No. 50249.....

IN NAME OF

RICHARD AND INEZ CARTWRIGHT

Surveyed..... AUGUST 8, .....1990

