


# T. 15., R. 10 E., W. M.

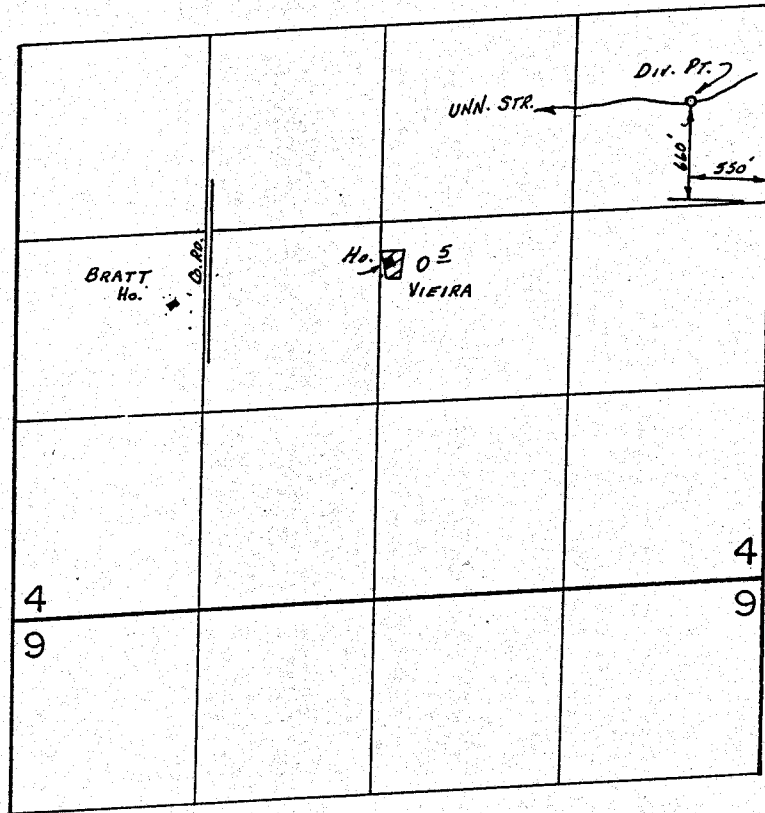

SCALE: 1" = 1320'

## FINAL PROOF SURVEY UNDER

Transfer No. 5154  
 64160 47452  
 Application No. 64161... Permit No. 47496...  
 IN NAME OF

GEORGE & BOBBIE LOU VIEIRA & C. STEPHAN & L. JANE BRATT

Surveyed July 17, 1984, by L.M. TOLL

5/18/86  
 34-83 NW 1/4  
 Dec 1987  
 Bob