


T.1S.R.3W.W.M.

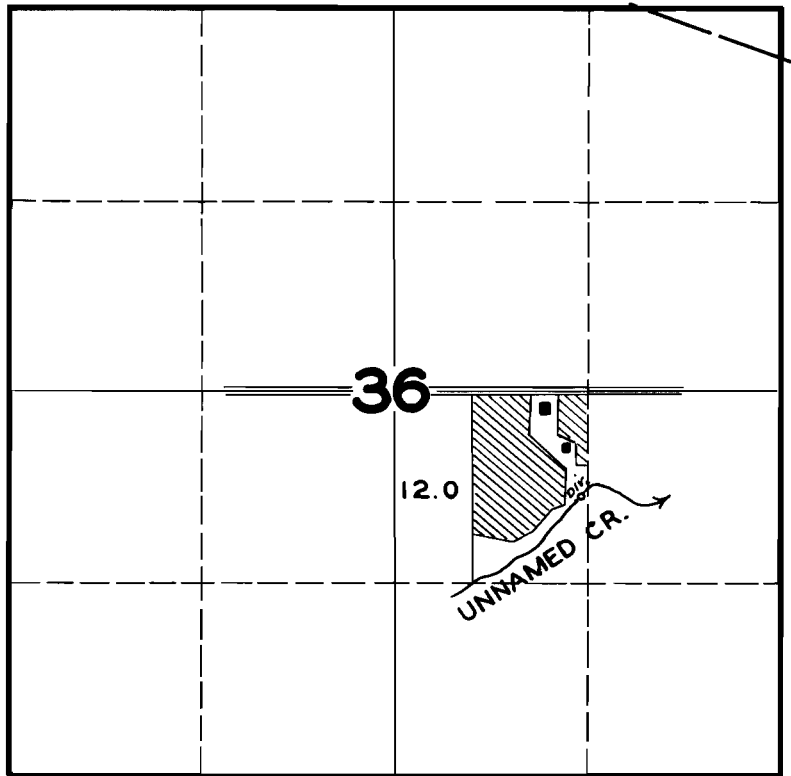

FINAL PROOF SURVEY
UNDER

Application No. **20422** Permit No. **15946**
IN NAME OF

OMER VUYSTEKE

Surveyed **JUNE 1, 1948**, by **JAS. E. BUNNELL**