


**T. 15. R. 3 W. W. M.**

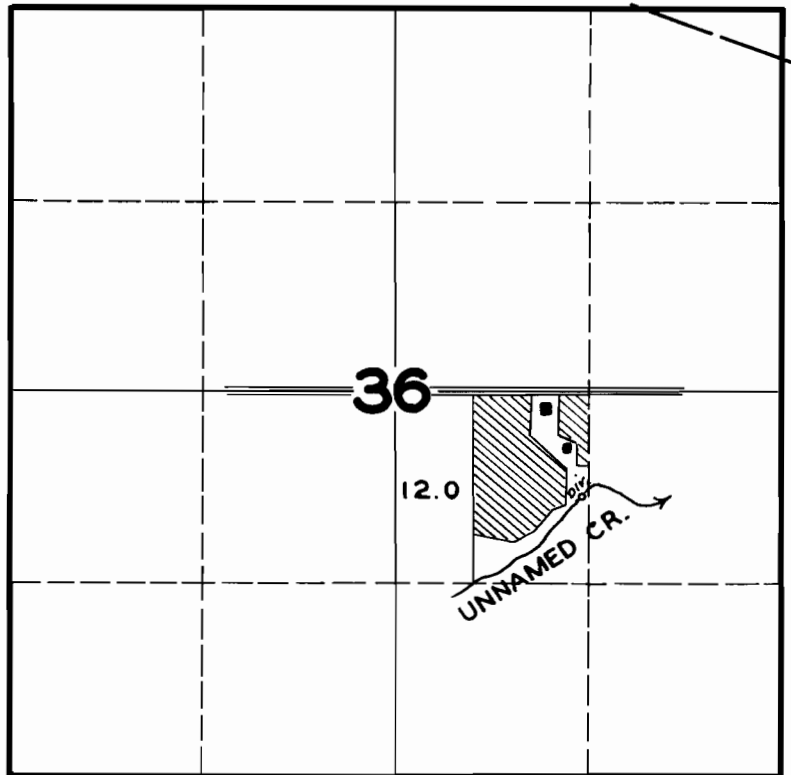

**FINAL PROOF SURVEY**  
UNDER

Application No. **20422** Permit No. **15946**  
IN NAME OF

**OMER VUYSTEKE**

Surveyed **JUNE 1, 1948**, by **JAS. E. BUNNELL**