


T. 1S., R. 4E., W.M.

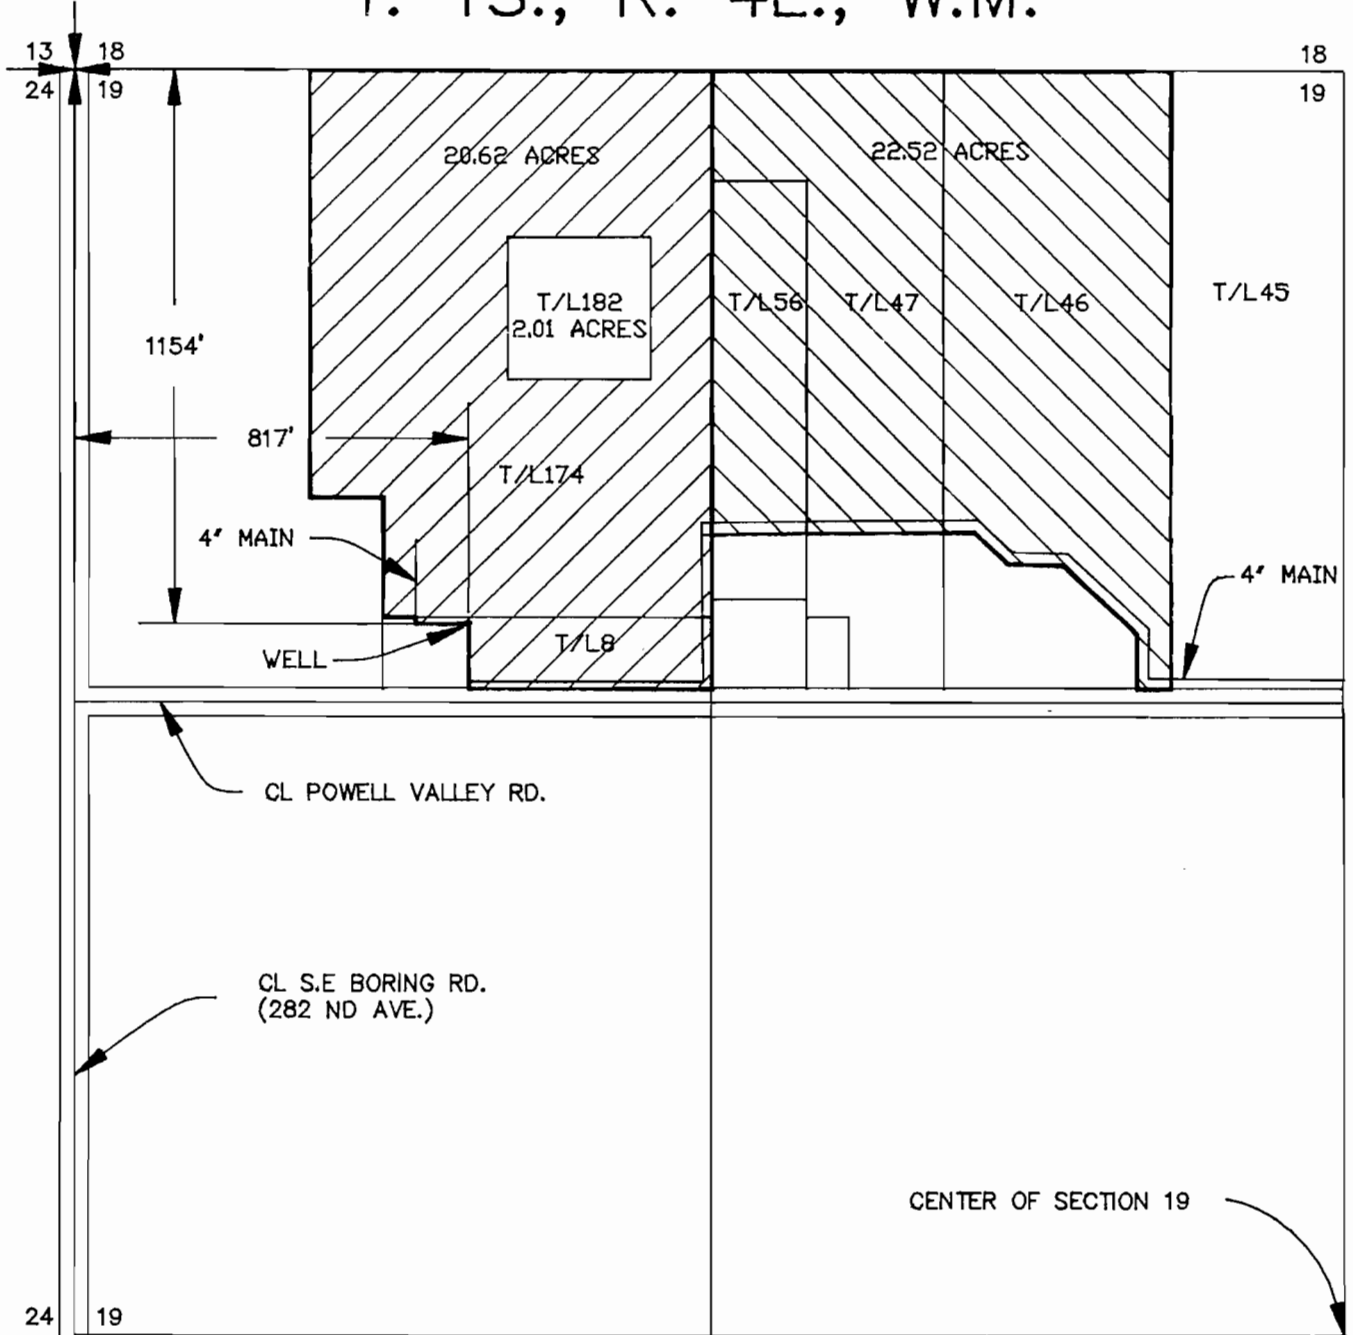


FINAL PROOF SURVEY

UNDER

APPLICATION NO. G-11719 PERMIT NO. G10878

IN NAME OF

JOHN HOLMLUND NURSERY

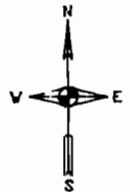

SCALE: 1"=400'

kpff

consulting engineers
portland oregon

SURVEYED JULY 24, 1990 BY *Stuart G. Cole* CWRE-151

DRAWN BY: STK

JOB NO.: 90069.01

DATE: NOV 29, 90

90069-1

DRAWING NO.