


T.38S.,R.7W. W.M.

THIS MAP IS FOR THE PURPOSE OF IDENTIFYING THE LOCATION OF THE WATER RIGHT ONLY AND IS NOT INTENDED TO PROVIDE LEGAL DIMENSIONS OR LOCATIONS OF PROPERTY OWNERSHIP LINES.

3 Primary
a.

SUPPLEMENTAL


SCALE: 1" = 400'

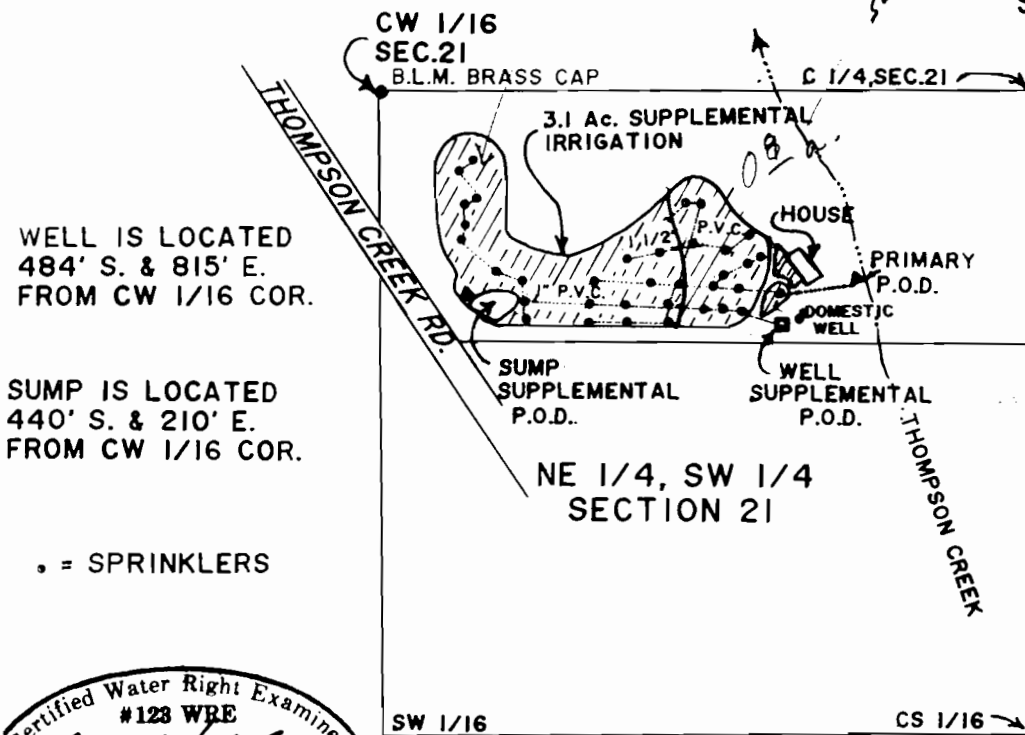

WELL IS LOCATED
484' S. & 815' E.
FROM CW 1/16 COR.

SUMP IS LOCATED
440' S. & 210' E.
FROM CW 1/16 COR.

• = SPRINKLERS

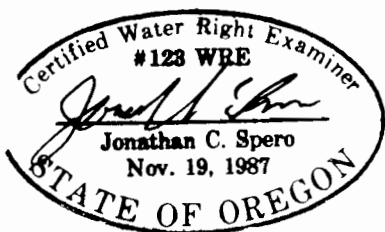

FINAL PROOF SURVEY UNDER

APPLICATION No. G-11725 PERMIT No. G-10834
SUPPLEMENTAL TO

PERMIT No. 4860 CERTIFICATE No. 4993

IN NAME OF
EVERETT CRUTCHFIELD

SURVEYED SEPT. 13, 1990, BY Jonathan C. Spero