


FINAL PROOF SURVEY MAP
IN THE NAME OF KENNETH H. KIMMELL
APPLICATION 69446 PERMIT 3C374
SECTION 4, T32S, R3W, W.M.

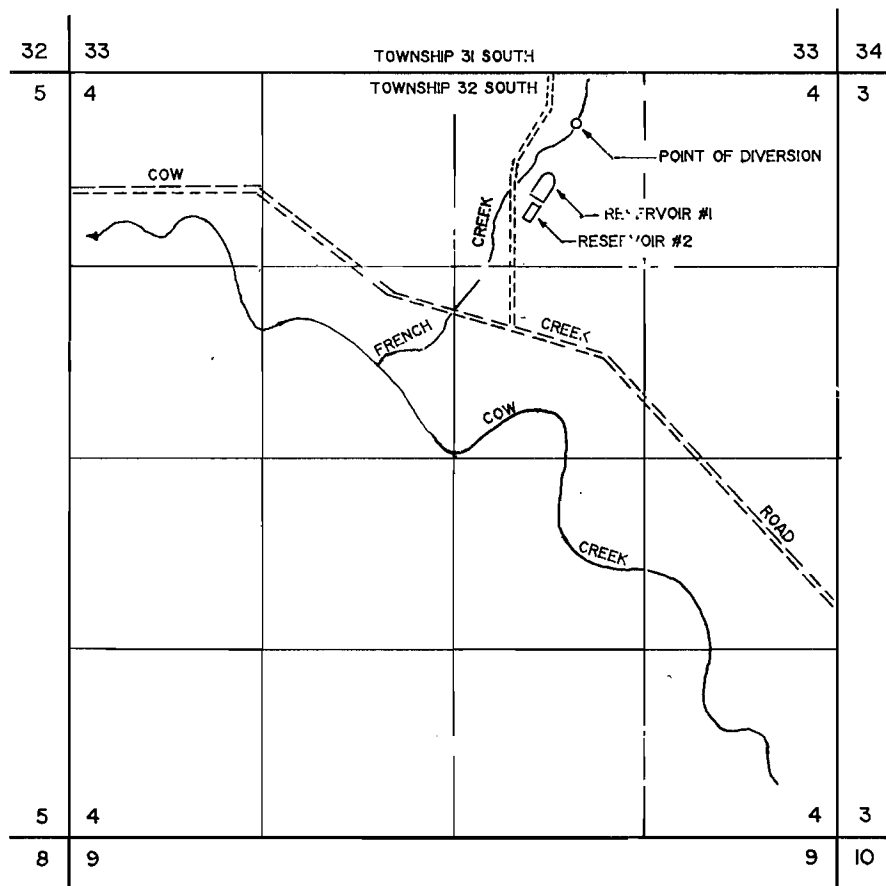


1 INCH = 1320 FEET



THE PURPOSE OF THIS MAP IS TO IDENTIFY THE LOCATION OF THE WATER RIGHT. IT IS NOT INTENDED TO PROVIDE INFORMATION RELATIVE TO THE LOCATION OF PROPERTY OWNERSHIP BOUNDARY LINES.

THE POINT OF DIVERSION IS LOCATED 330 FEET SOUTH AND 830 FEET EAST FROM THE NORTH 1/4 CORNER OF SECTION 4, BEING WITHIN THE NW 1/4 OF THE NE 1/4 OF SECTION 4, TOWNSHIP 32 SOUTH, RANGE 3 WEST, W.M..

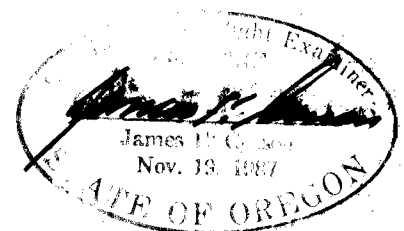

FINAL PROOF SURVEY MAP

IN THE NAME OF KENNETH H. KIMMELL


SECTION 33, T31S, R3W, W.M.
SECTION 4, T32S, R3W, W.M.



1 INCH = 1320 FEET

APPLICATION 69446

PERMIT 50374

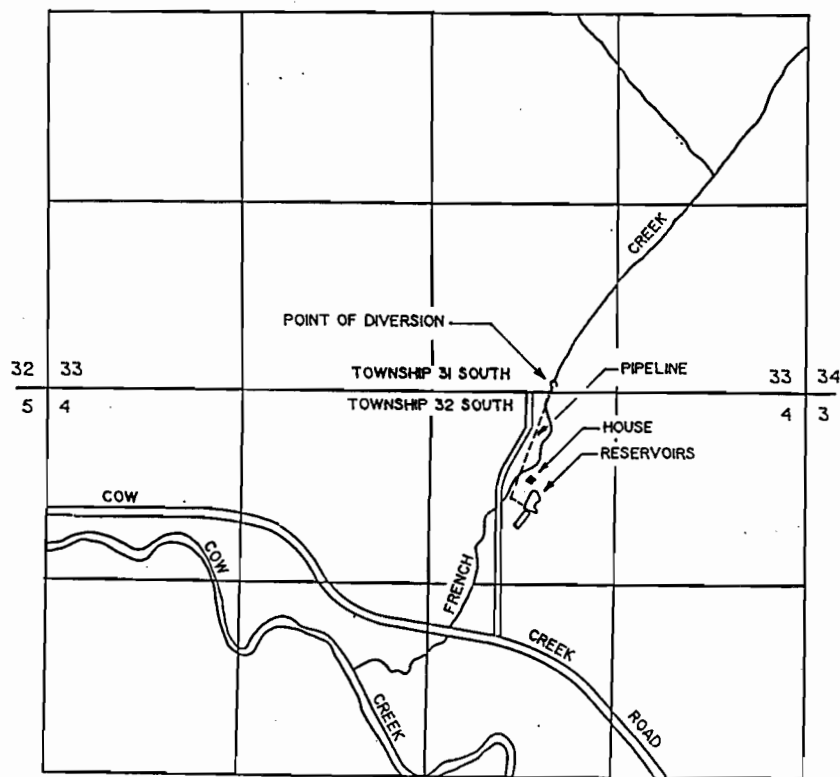

THE POINT OF DIVERSION IS LOCATED 60 FEET NORTH
AND 1760 FEET WEST FROM THE SOUTHEAST CORNER OF SECTION 33,
BEING WITHIN THE SW 1/4 OF THE SE 1/4 OF SECTION 33, TOWNSHIP
31 SOUTH, RANGE 3 WEST, W.M., DOUGLAS COUNTY.

THE PURPOSE OF THIS MAP IS TO IDENTIFY THE LOCATION OF
THE WATER RIGHT. IT IS NOT INTENDED TO PROVIDE INFOR-
MATION RELATIVE TO THE LOCATION OF PROPERTY OWNERSHIP
BOUNDARY LINES.

