


T. 9 S. R. 1 W. W. M.

OCT 04 1990

WATER SOURCE

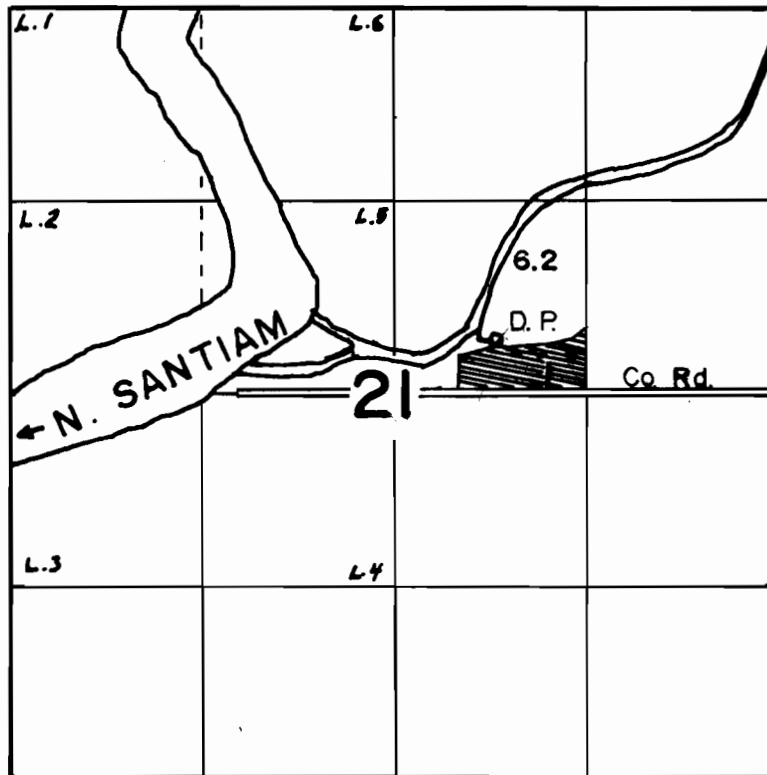


Scale 1" = 1320'

Div. Pt. is located 350' N. & 1920' W. from E 1/4 Cor.

# WATER RIGHT MAP FOR RAY DUDKOWSKI

Surveyed Mar. 16, 1990 by

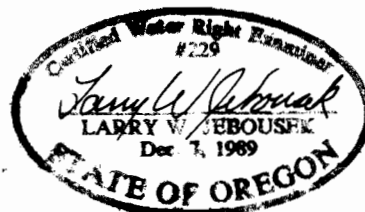

THIS MAP WAS PREPARED FOR THE PURPOSE OF IDENTIFYING THE LOCATION OF A WATER RIGHT ONLY AND IS NOT INTENDED TO PROVIDE LEGAL DIMENSIONS OR LOCATION OF PROPERTY OWNERSHIP LINES.