
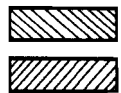


T. 6 S. R. 2 W. W. M.

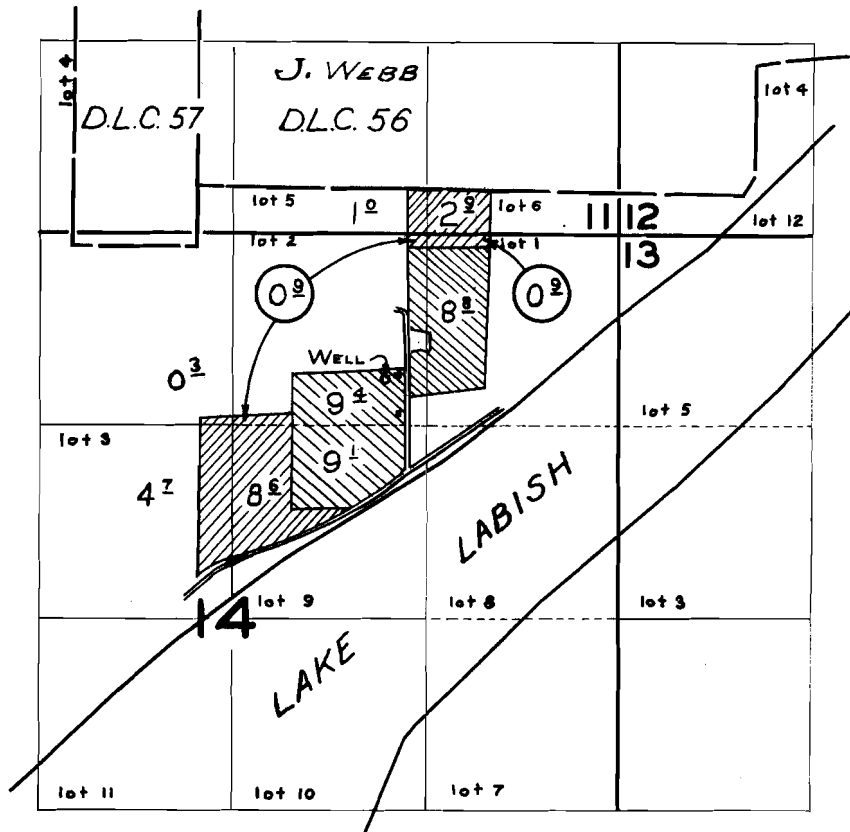

APPL. No. G-2050

APPL. No. G-2639

FINAL PROOF SURVEY UNDER

Application No. G-2050 Permit No. G-1883
G-2639 G-2445
 IN NAME OF

PAUL V. BAUGHMAN

Surveyed JUN. 23 1964, by R. JACKSON