


T. 6 S. R. 2 W. W. M.

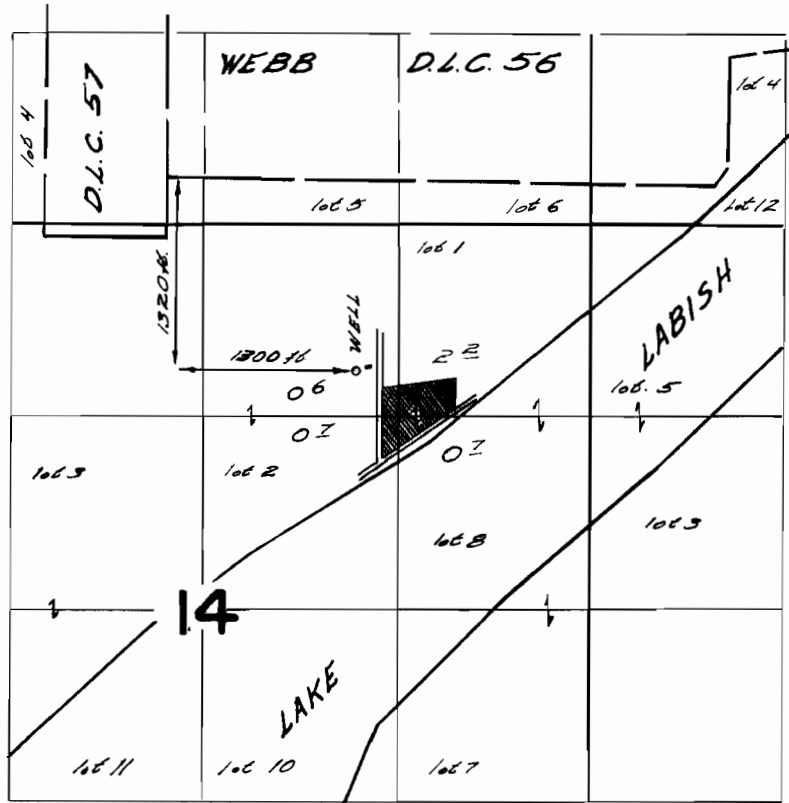

FINAL PROOF SURVEY UNDER

Application No. G-3734 Permit No. G-3528
IN NAME OF

PAUL V. BAUGHMAN

Surveyed Oct. 22 1967, by W. d. Ruppert