



T. 1S., R. 4E., W.M.

SECTION 31

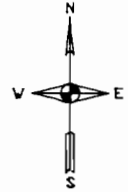

SCALE: 1"=1320'

THE PURPOSE OF THIS MAP IS TO IDENTIFY THE WATER RIGHT. IT IS NOT INTENDED TO PROVIDE LEGAL DIMENSIONS OR TO SHOW THE LOCATION OF PROPERTY OWNERSHIP LINES.

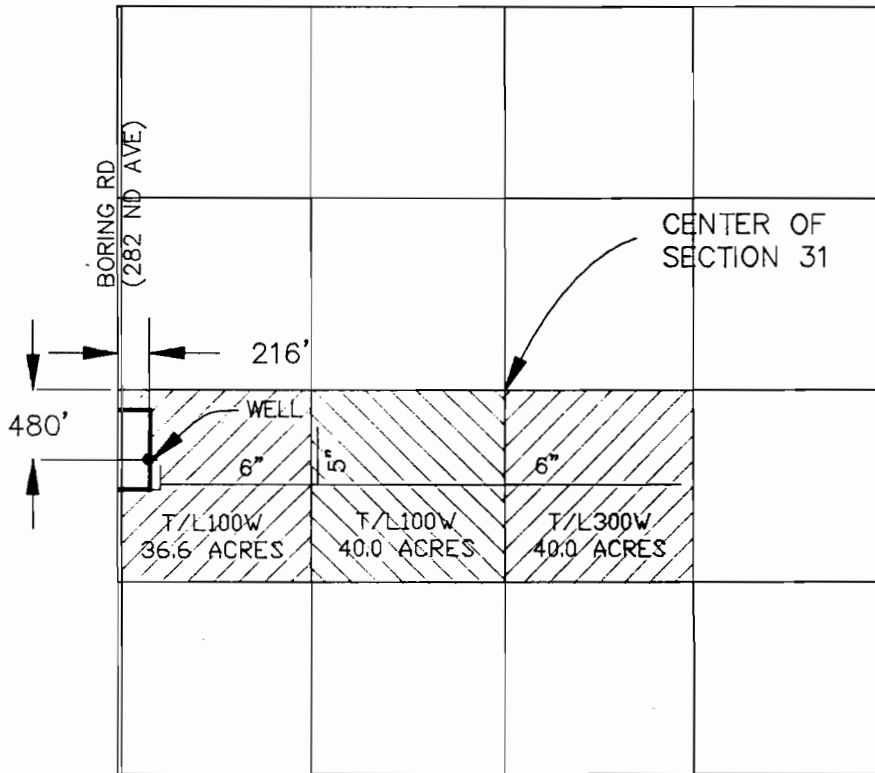


FINAL PROOF SURVEY

UNDER

APPLICATION NO. G-11720 PERMIT NO. G10833

IN NAME OF

JOHN HOLMLUND NURSERY

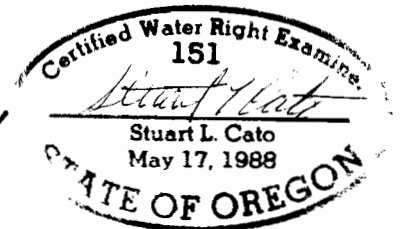

kpff

consulting engineers
portland oregon

SURVEYED JULY 24, 1990 BY Stuart L. Cato CWRE-151

DRAWN BY: STK

JOB NO.: 90069.01

DATE: OCT 12, 90

90069-2

DRAWING NO.