


T. 29S., R. 6 W., W.M.

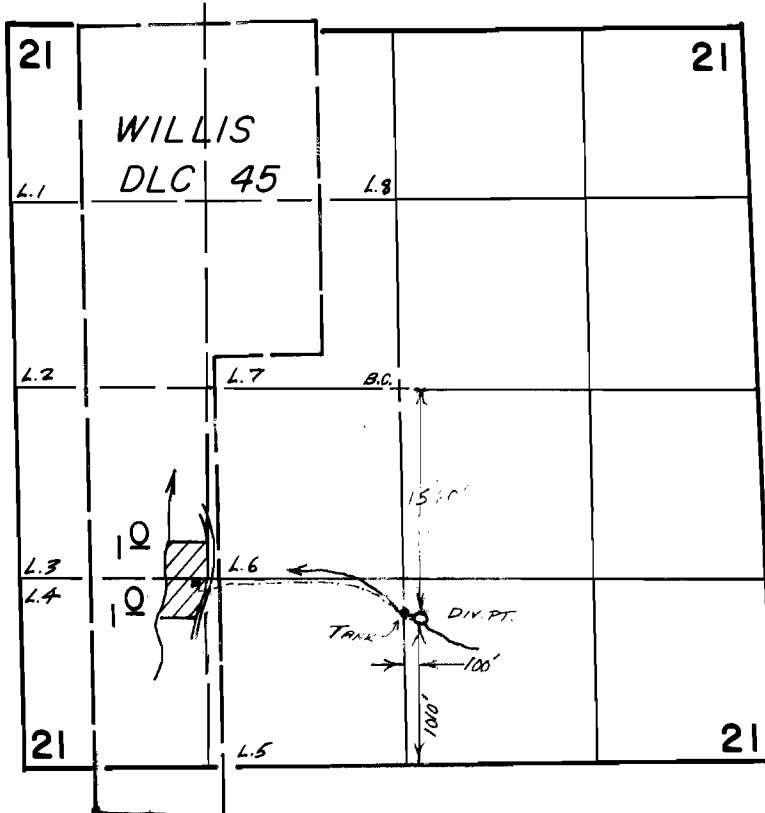

Scale : 1" = 1' = 1320'

**FINAL PROOF SURVEY**  
UNDER

Application No. 56.317. Permit No. 42389...  
IN NAME OF

.....CLARENCE.....R.....STAPLES.....

Surveyed Sept. 13, 1978, by D. Henry.....  
March 7, 1995 by S. DeHaas