


RECEIVED

JAN 14 1991

OCT 01 1990


WATER RESOURCES DEPT
SALEM, OREGON

T.14S., R.5W., W.M.

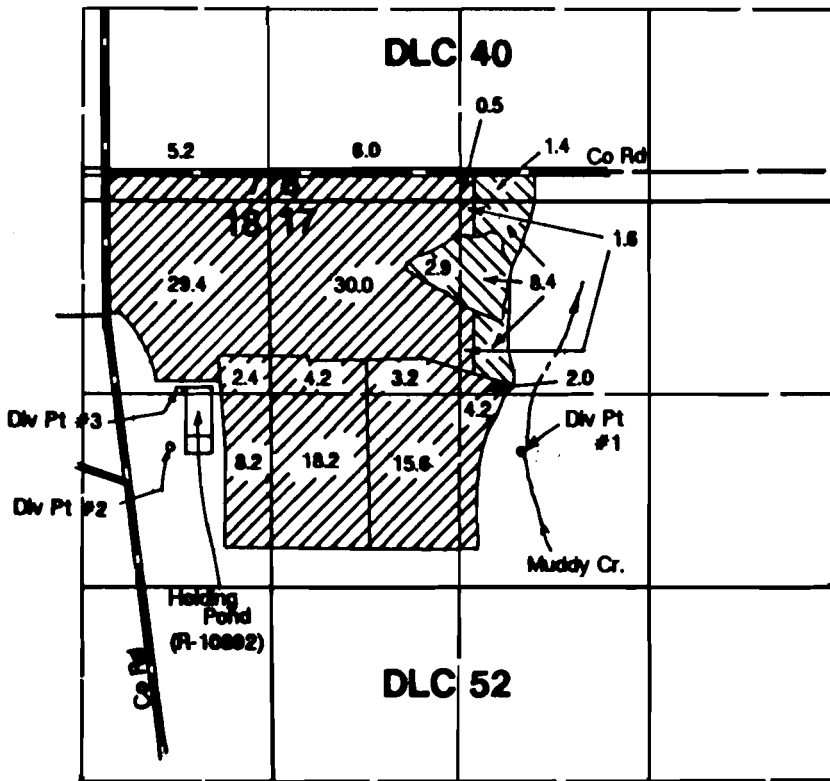

Div. Pt. #1 located 1700'S & 1750'E from NW corner Section 17.
 Div. Pt. #2 located 1675'S & 700'W from NE corner Section 18.
 Div. Pt. #3 located 1300'S & 625'W from NE corner Section 18.

Final Proof Survey

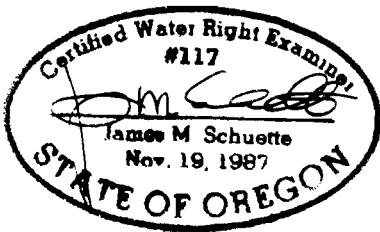

R-69285 R-10892
 Application #69286 Permit #50183

In Name Of

John Van Beek

Surveyed on September 20, 1990 by JM Schuette

NOTE: Map is for purpose of identifying location of water right and has no intent to dimension or locate property ownership lines.