


# T.6S.R.8W.W.M.

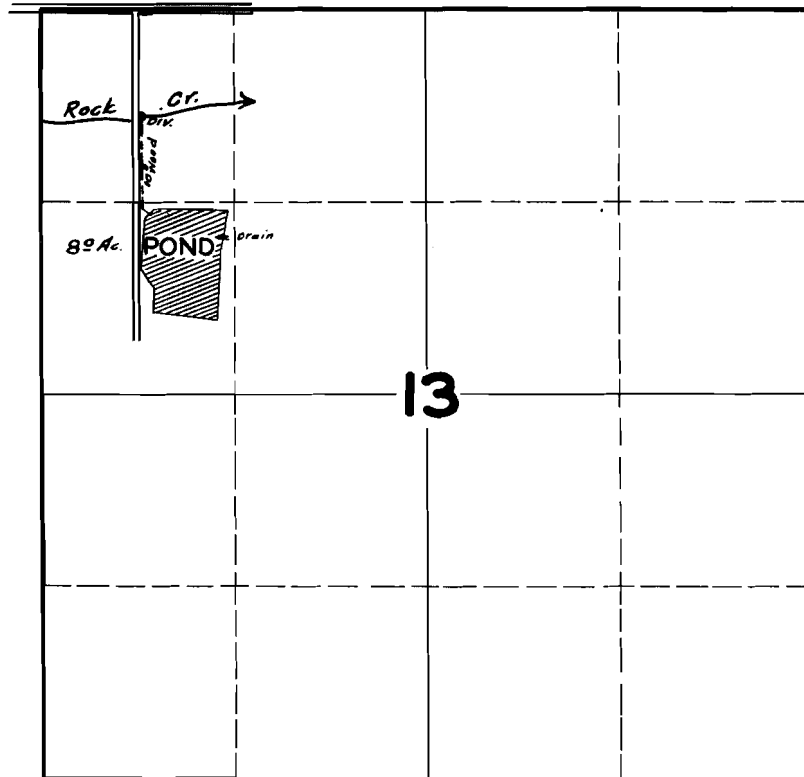

## FINAL PROOF SURVEY

UNDER

R-20040 R-783  
Application No. 20041 Permit No. 15608

IN NAME OF

POLK OPERATING COMPANY

Surveyed JUNE 18 1945

*John C. Bunnell*