


# T.34S., R.1W., W.M.

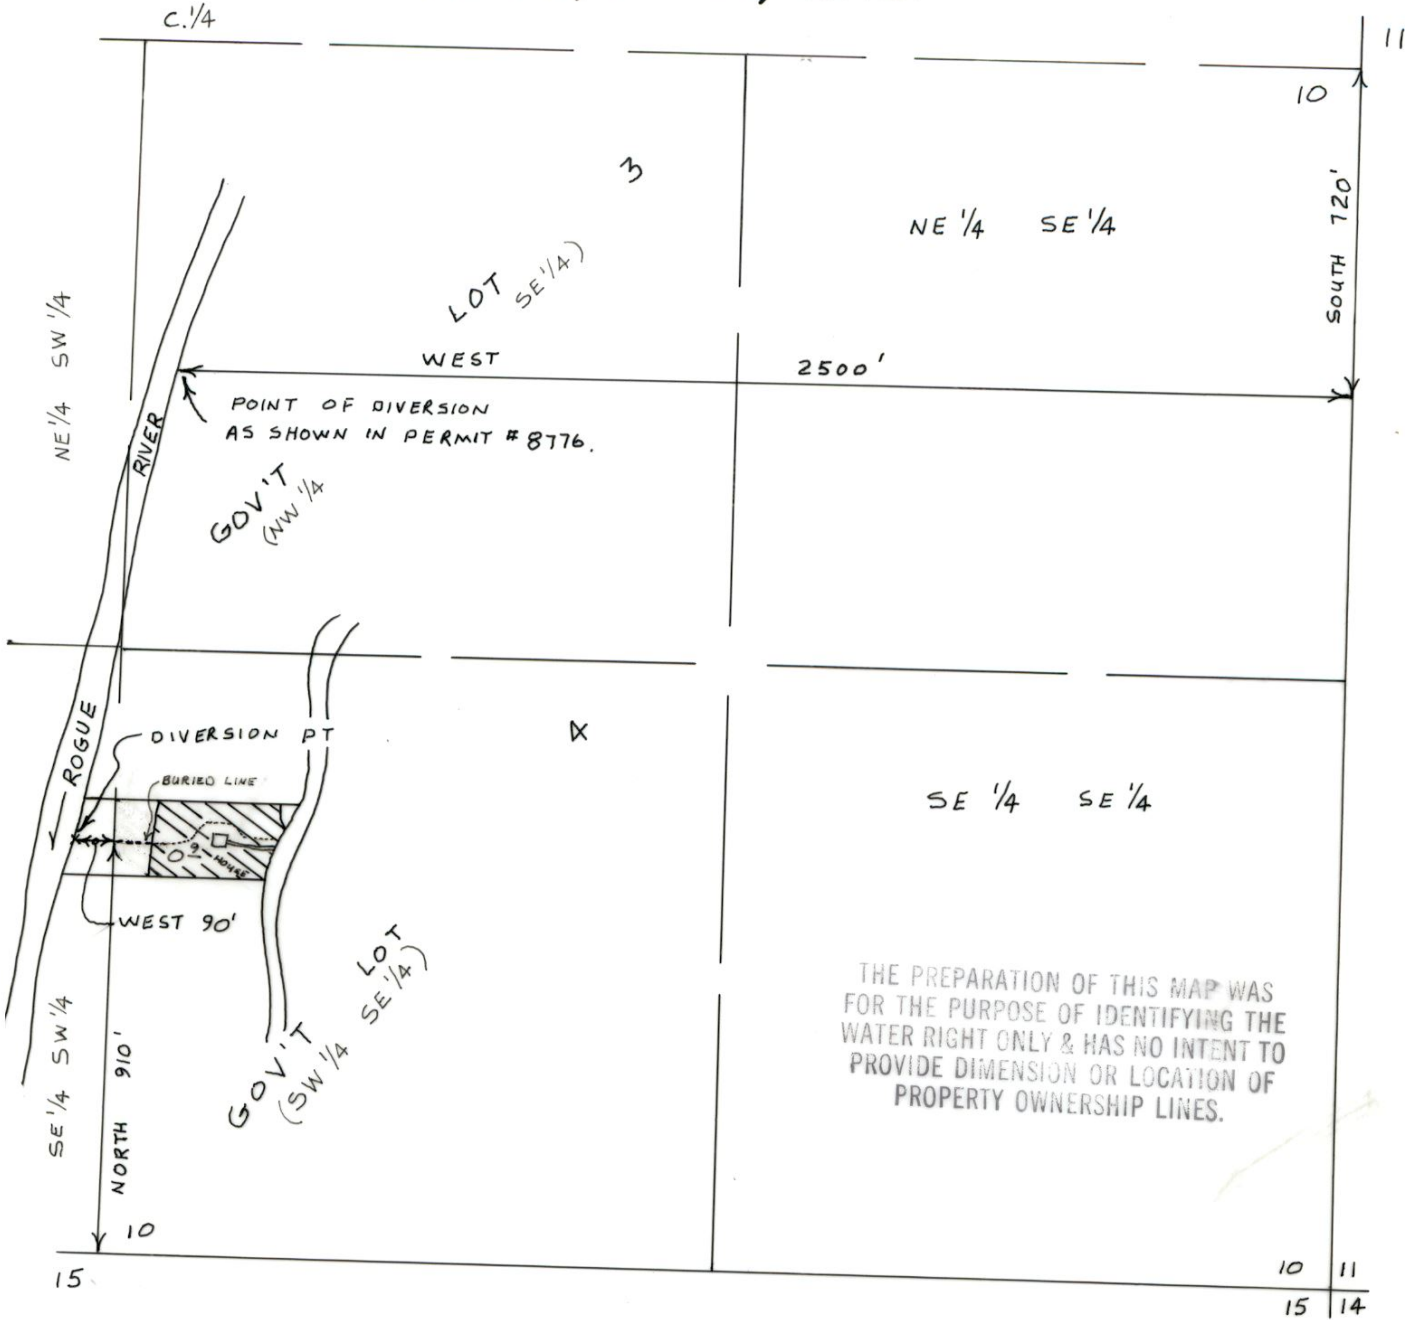


FINAL PROOF MAP  
under

Application No. T-12434 Permit No. T-6396  
In Name Of

PETER AND RITA CASPER

Mapped: APRIL 5, 1991 Scale: 1"=400'

Mapped By: L.J. Friar & Associates P.C.  
Consulting Land Surveyors  
304 South Holly Street  
Medford, OR 97501  
(503) 772-2782

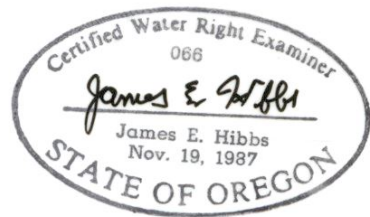

**RECEIVED**

APR 10 1991

WATER RESOURCES DEPT.  
SALEM, OREGON