
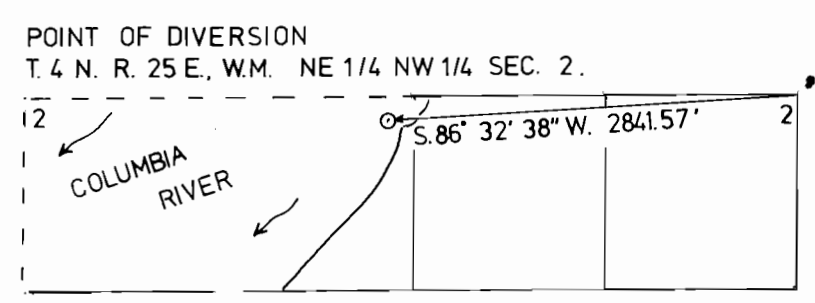


T. 2 N., R. 26 E., W.M.

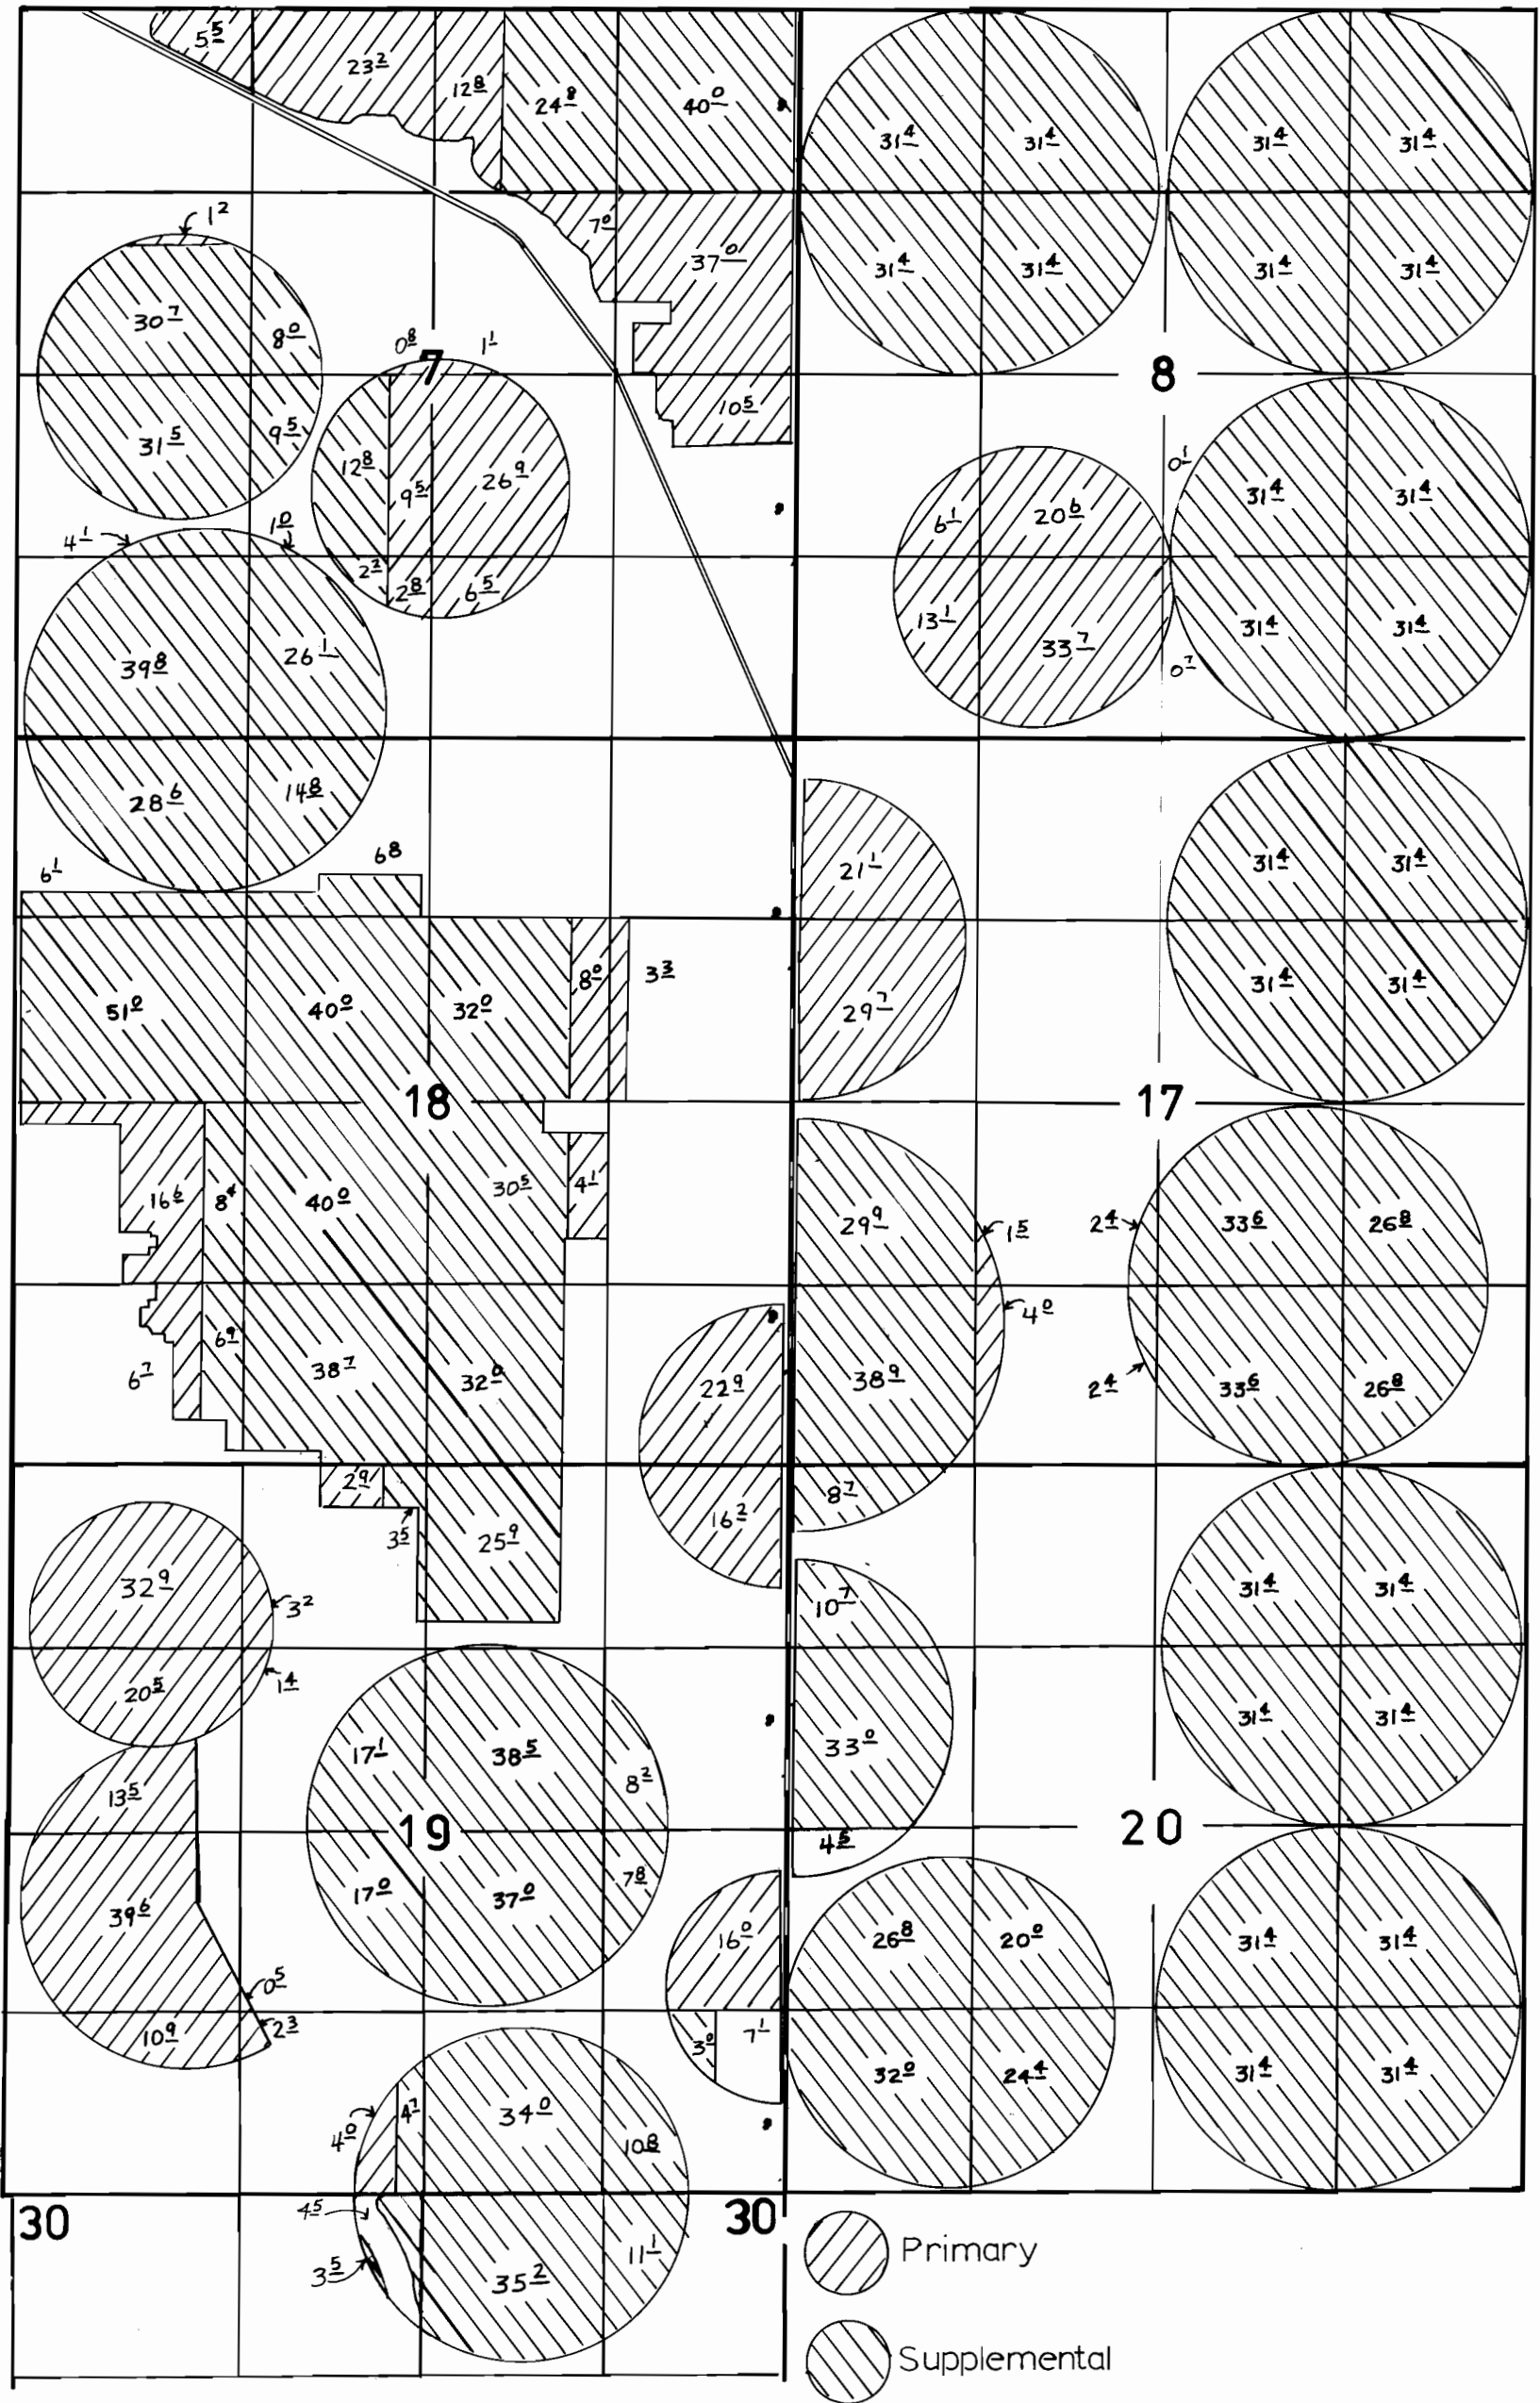

FINAL PROOF SURVEY UNDER

Application No. 55653 Permit No. 43877
IN NAME OF

Surveyed 10-15 1993. by J. MILLER



1"=1320'

Drafted 12-3-1993 J. Miller 41049-1208-76 EC, 41L, 41R, 42L, 42R.