


T.3-4S. R.1-2W.W.M.

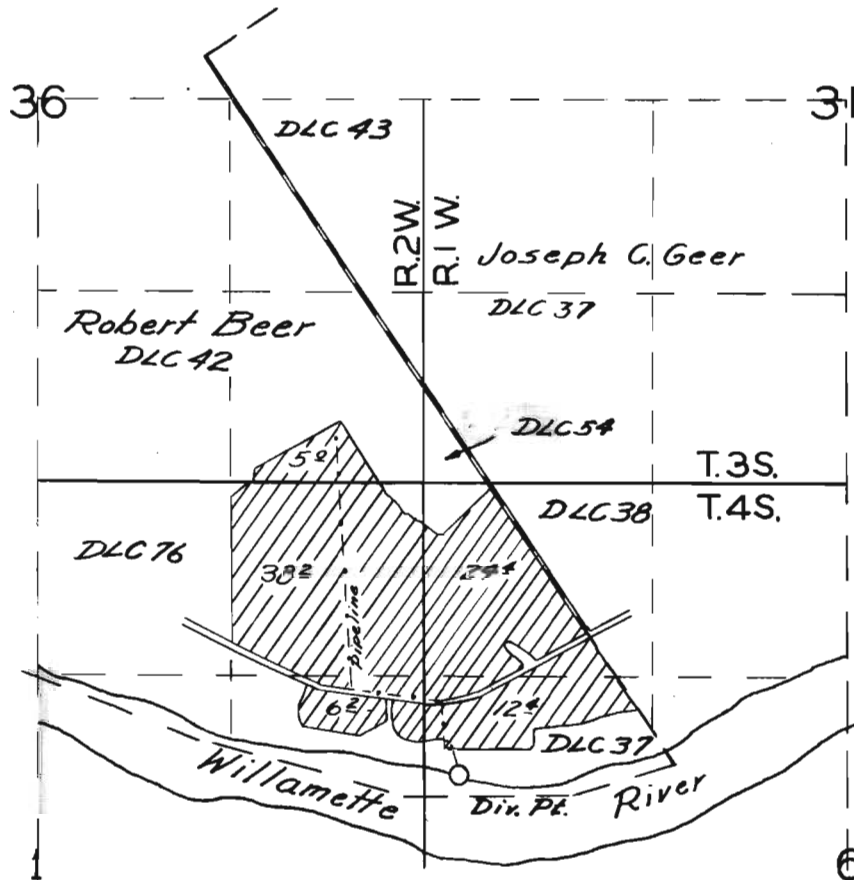

FINAL PROOF SURVEY
UNDER

Application No. 18588 Permit No. 14193
IN NAME OF

Mary Elizabeth & L.B. Meneses Jr.

Surveyed April 23 1935, by T. Jones