


RECEIVED  
MAY 19 1977  
WATER RESOURCES DEPT  
SALEM, OREGON

RECEIVED  
FEB-19 1977  
WATER RESOURCES DEPT  
SALEM, OREGON  
Application No. G-7698  
Permit No.

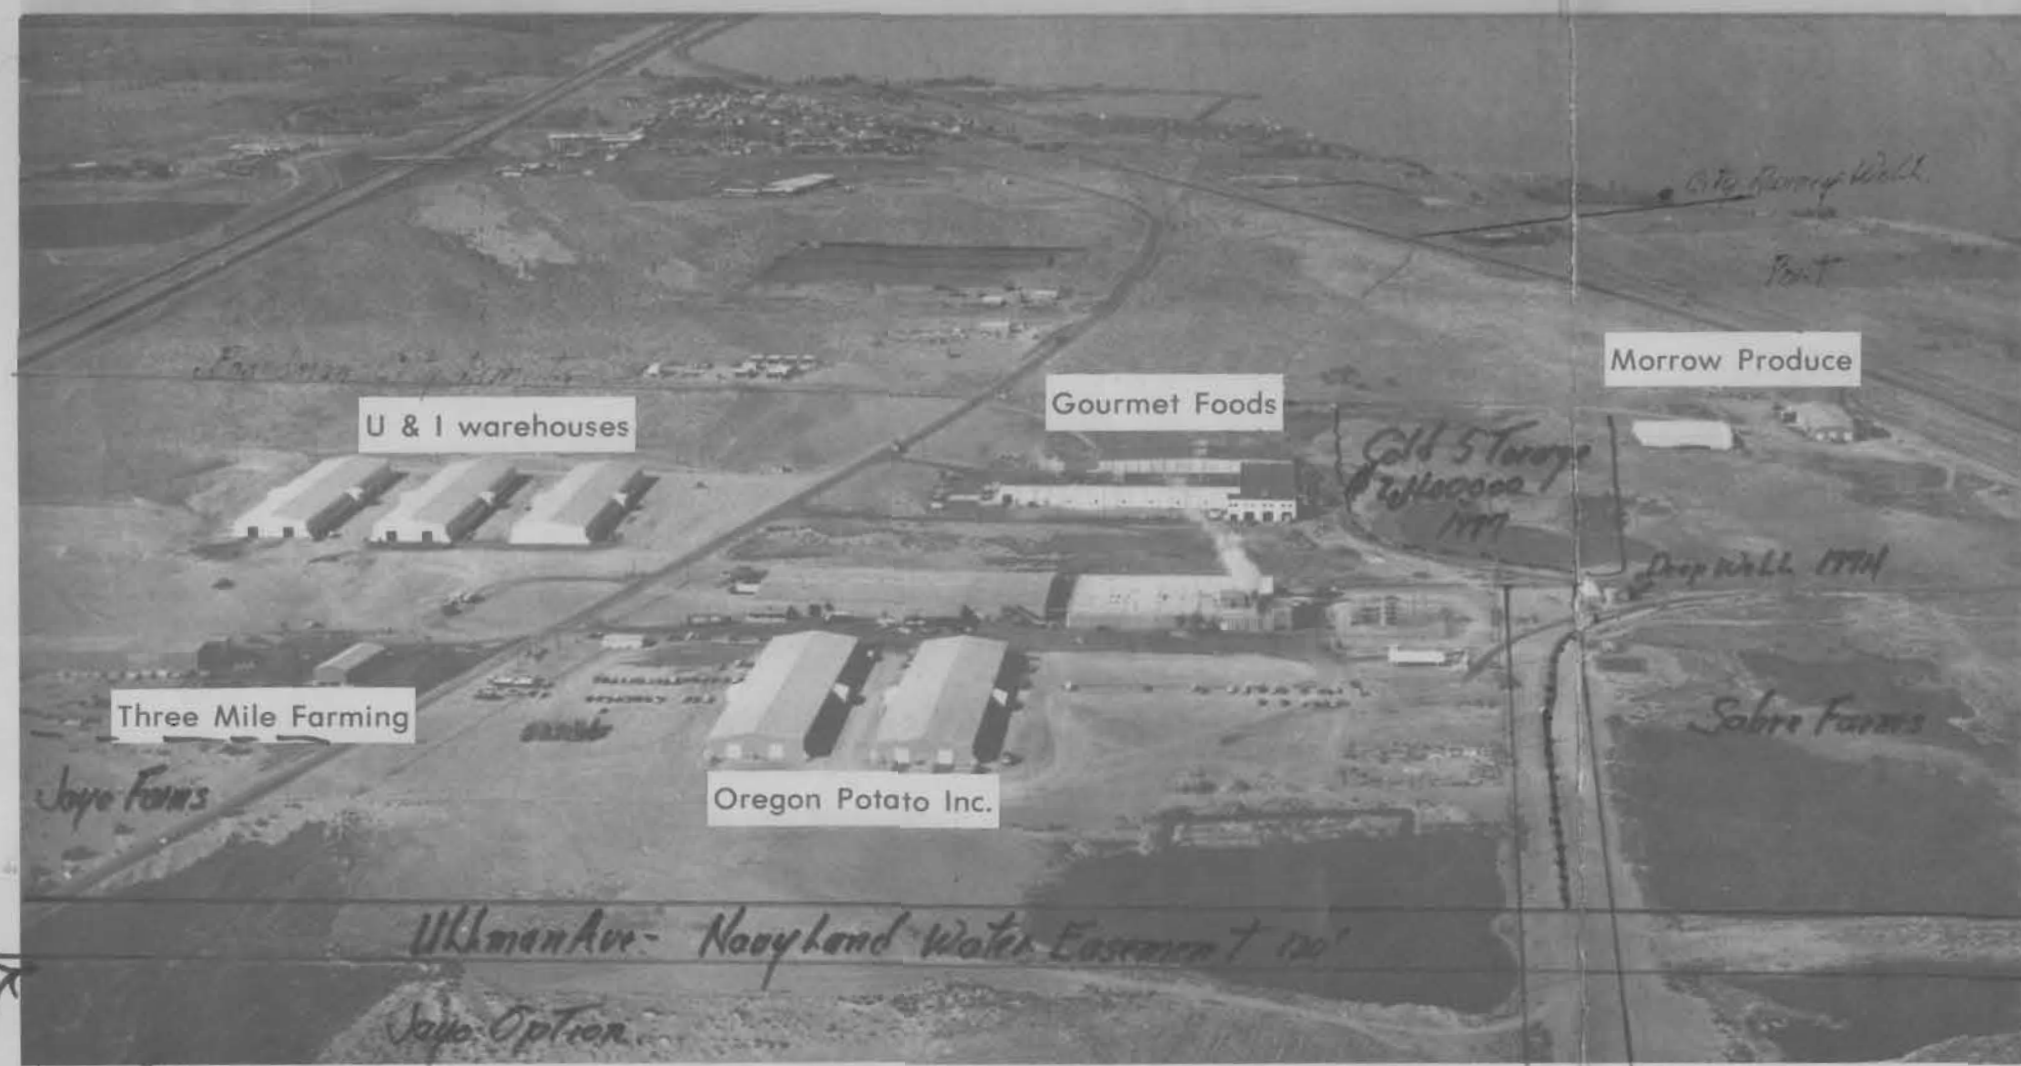

### PORT OF MORROW PROPOSED WATERWELL LOCATION

MORROW COUNTY OREGON  
SCALE 1" = 800' JANUARY 1977

Application No. G-7698  
Permit No. G-7158

RECEIVED  
FEB 28 1977  
WATER RESOURCES DEPT  
SALEM, OREGON



STORCH CORPORATION / ENGINEERS

There are \$15 million worth of plants located in the Port of Morrow food processing park on the outskirts of Boardman (top center). The park has two fresh potato packing sheds, a french fry plant, a potato flaking plant, a farm headquarters and five large potato storage warehouses. Rupert Kennedy, port manager, anticipates \$40 million worth of new processing plants will be located in the park in the next decade.

RECEIVED  
MAY 19 1977  
WATER RESOURCES DEPT  
SALEM, OREGON

If the Port of Morrow food processing park's keeps growing Port Manager Rupert Kennedy (right) said he'll have to build another sign board.

Application No. G-7698  
Permit No. 1 MARINE DRIVE - BOARDMAN, OREGON - (503) 481-2695

Oscar Peterson-President, LeRoy Gardner-Vice-President, Jack Carlson-Secretary, Lawrence Lindsay-Treasurer, Dewey W. West-Commissioner, Rupert W. Kennedy-Coordinator