
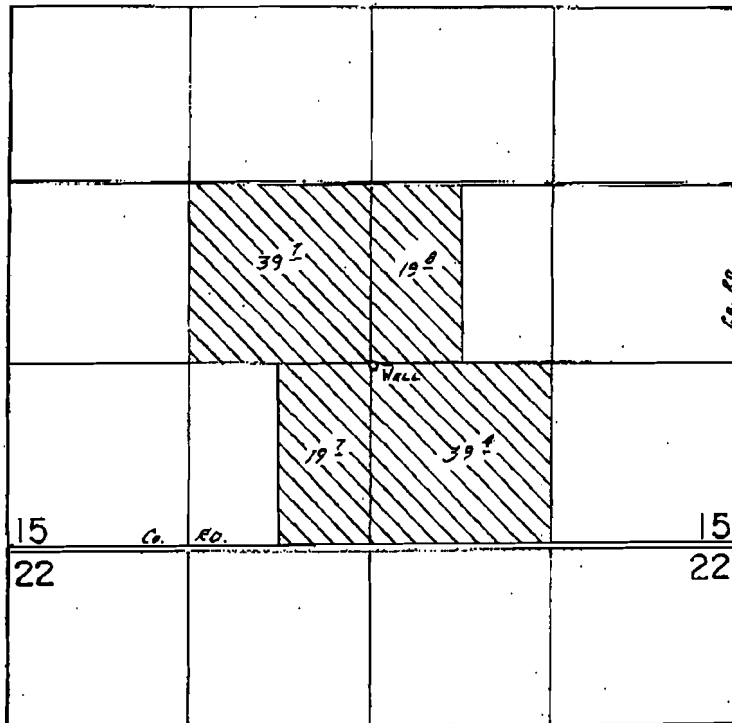


G-10046  
68546

T.27S., R.17E., W.M.

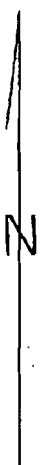

WELL LOC.: 1310 N. & 2630 W. FROM SE COR. SEC. 15.

Post-It™ brand fax transmittal memo 7671		# of pages - 1 of 1	
To	Jake Szlamet	From	Roger Suterfield
Co.		Co.	
Dept.		Phone #	
Fax #		Fax #	

SCALE: 1" = 1320'

# FINAL PROOF SURVEY UNDER Preliminary Draft

Application No. G-9707. Permit No. G-10046.  
IN NAME OF

MARION F. KANE (Ginter)

Surveyed June 8, 1988, by R.W. BISHOP

12/20/88  
JWB

41037-579-1950