

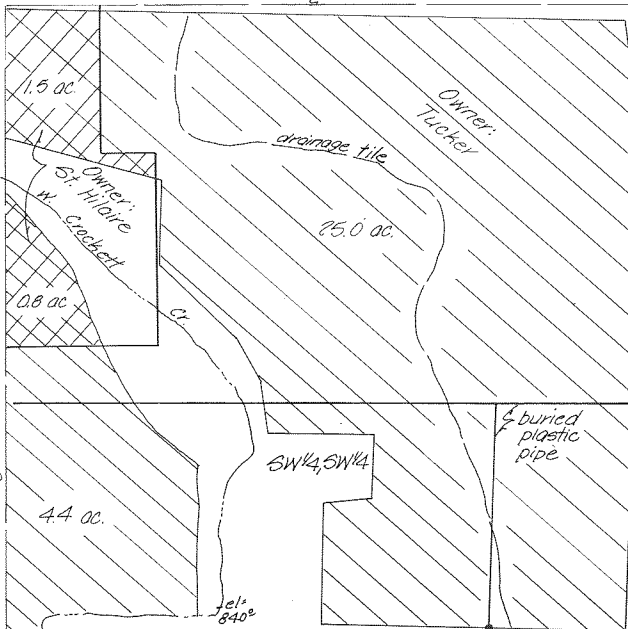
NW1/4, SW1/4

G-11051

NE1/4,
SW1/4

Ferndale Road

Winthrop Road

SE1/4,
SW1/4SW1/4
Sec 23

NW1/4, NW1/4 Sec 26

Well 2930
103° 29'30\"/>
K KRUMBEIN ENGINEERING LTD.ENGINEERS - SURVEYORS - PLANNERS
361 S.E. Second Pendleton, OregonScale
1"=200'Date
8-18-90Drn. By
MLDCkd. By
DHKDrng. No.
9006AJob No.
90-12

Revision 1

Revision 2

Final Proof Survey

STANLEY TUCKER

Permit No. G-11051

Application No. G-12072

SW1/4, SW1/4, Sec. 23, T6N, R35E, W.M.

